


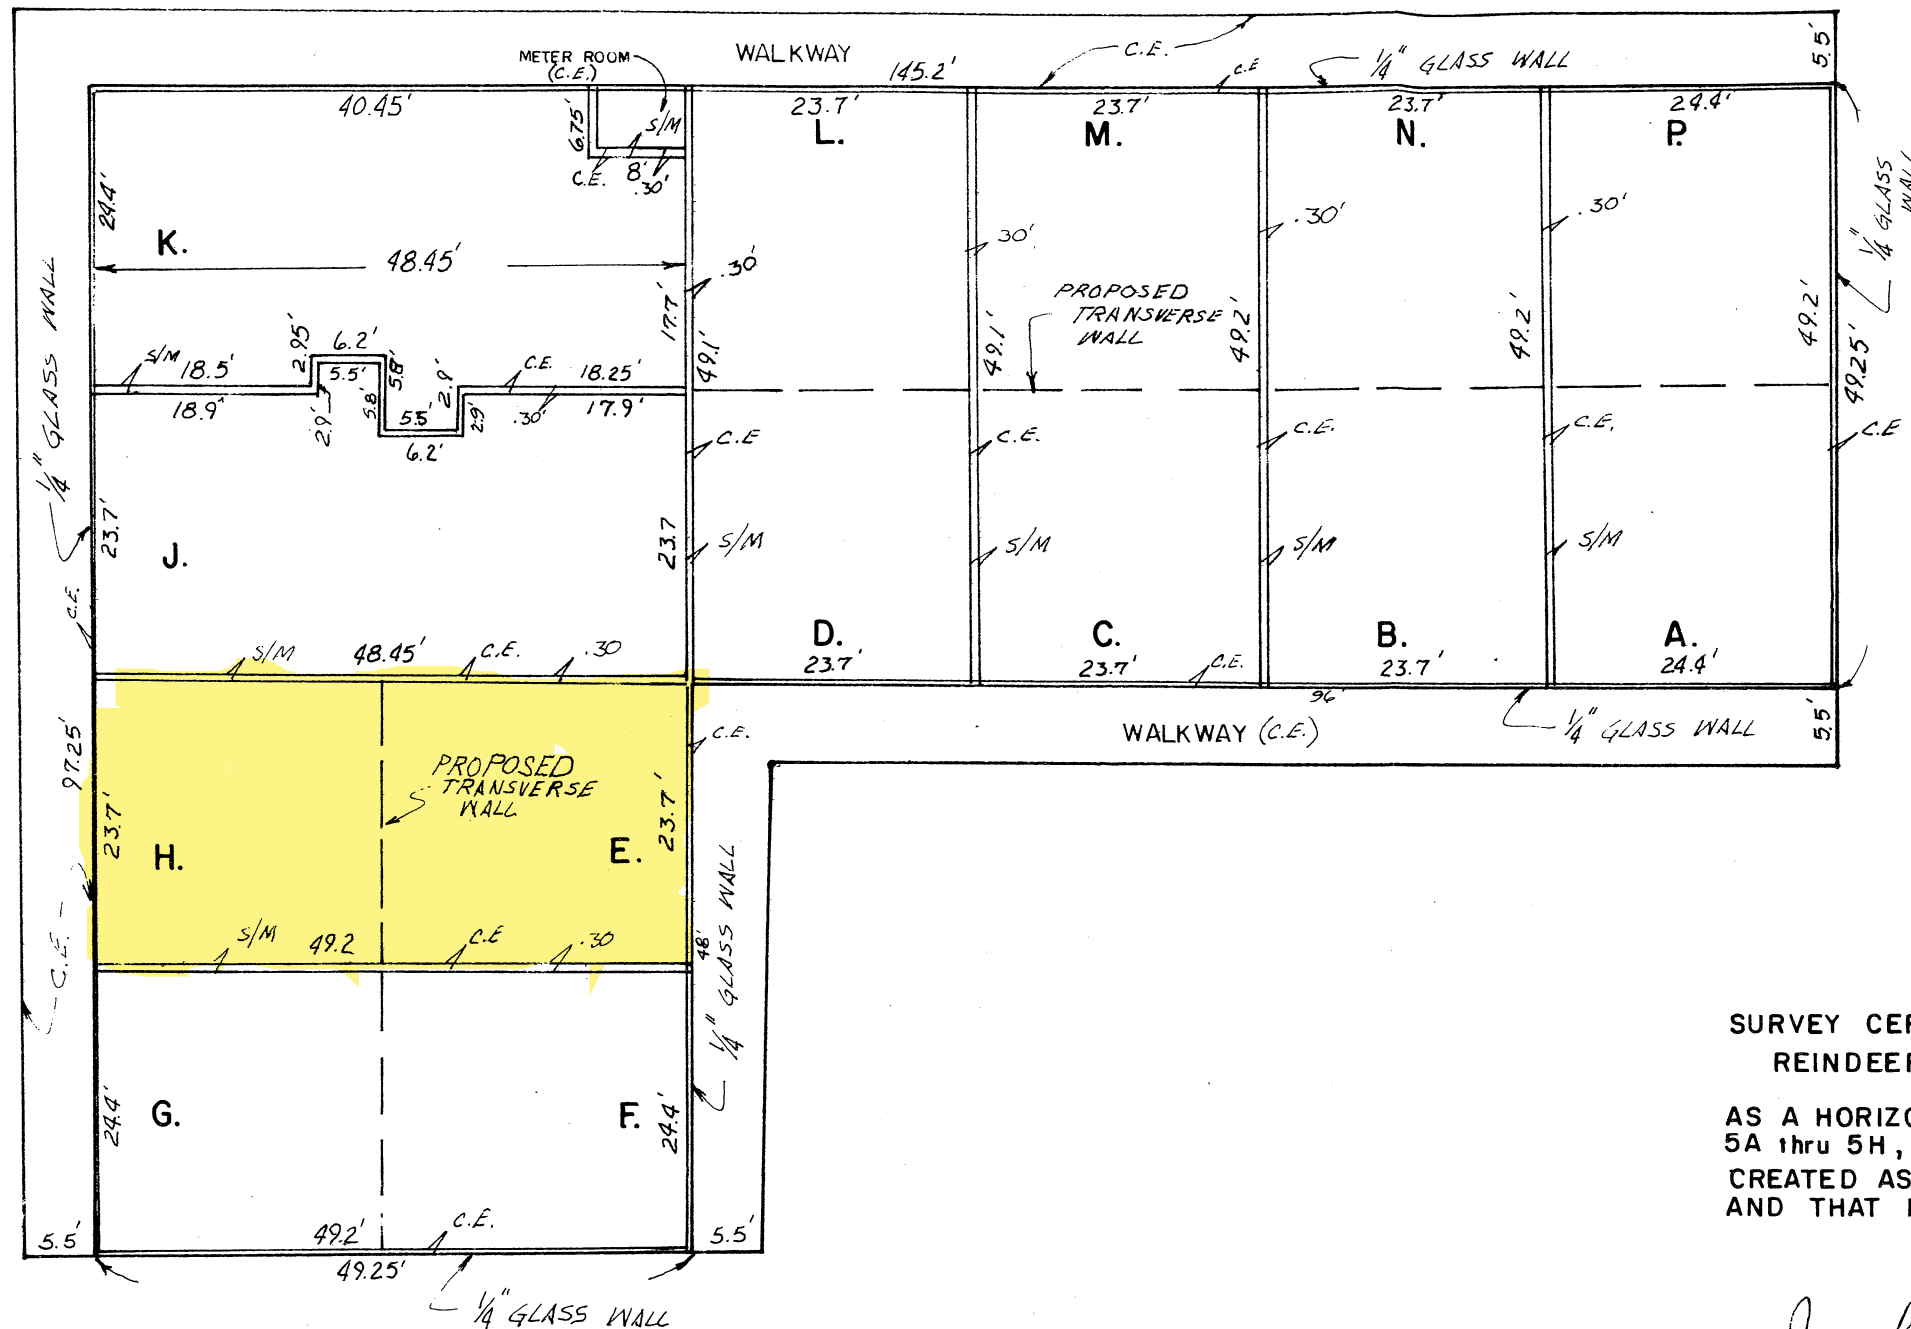

NOTES:

- 1) C.E. = COMMON ELEMENT
- 2) WIDTH OF UNITS ARE MEASURED FROM:
 - a) OUTSIDE SURFACE OF SHEETROCK WALLS AT RIGHT ANGLES.
 - b) OUTSIDE SURFACE OF SHEETROCK WALL TO INSIDE SURFACE OF GLASS WALL AT RIGHT ANGLES.
 - c) INSIDE SURFACE OF GLASS WALLS AT RIGHT ANGLES.

APPLY OPTIONS a, b, OR c WHERE APPLICABLE.

- 3) UNIT LETTER DESIGNATION ARE TYPICAL FOR BLDGS. 1, 5, & 7.
- 4) METER ROOM SUBJECT TO AGREEMENT WITH N.O.P.S.I.
- 5) S/M = SHEETROCK WITH METAL STUDS.

SURVEY CERTIFIED CORRECT TO:
REINDEER II, A PARTNERSHIP

AS A HORIZONTAL SURVEY OF UNITS 1A thru 1H, 1J thru 1N, 1P, 5A thru 5H, 5J thru 5N, 5P, 7A thru 7H, 7J thru 7N, 7P TO BE CREATED AS CONDOMINIUM UNITS ACCORDING TO THIS SURVEY AND THAT NOTES HEREON ARE TRUE AND CORRECT.

Joseph M. Marques
JOSEPH M. MARQUES
REG. NO. 4457

TYPICAL HORIZONTAL UNIT PLAN
BUILDINGS 1, 5, & 7

HORIZONTAL UNIT PLANS BUILDINGS 1, 5, & 7 DEER PARK BUSINESS PARK THIRD DISTRICT		
SCALE: 1" = 15'	APPROVED BY	DRAWN BY
DATE: 4-6-83		
 UNIVERSAL LAND SURVEYORS INC.		
		DRAWING NUMBER