


Wetgace

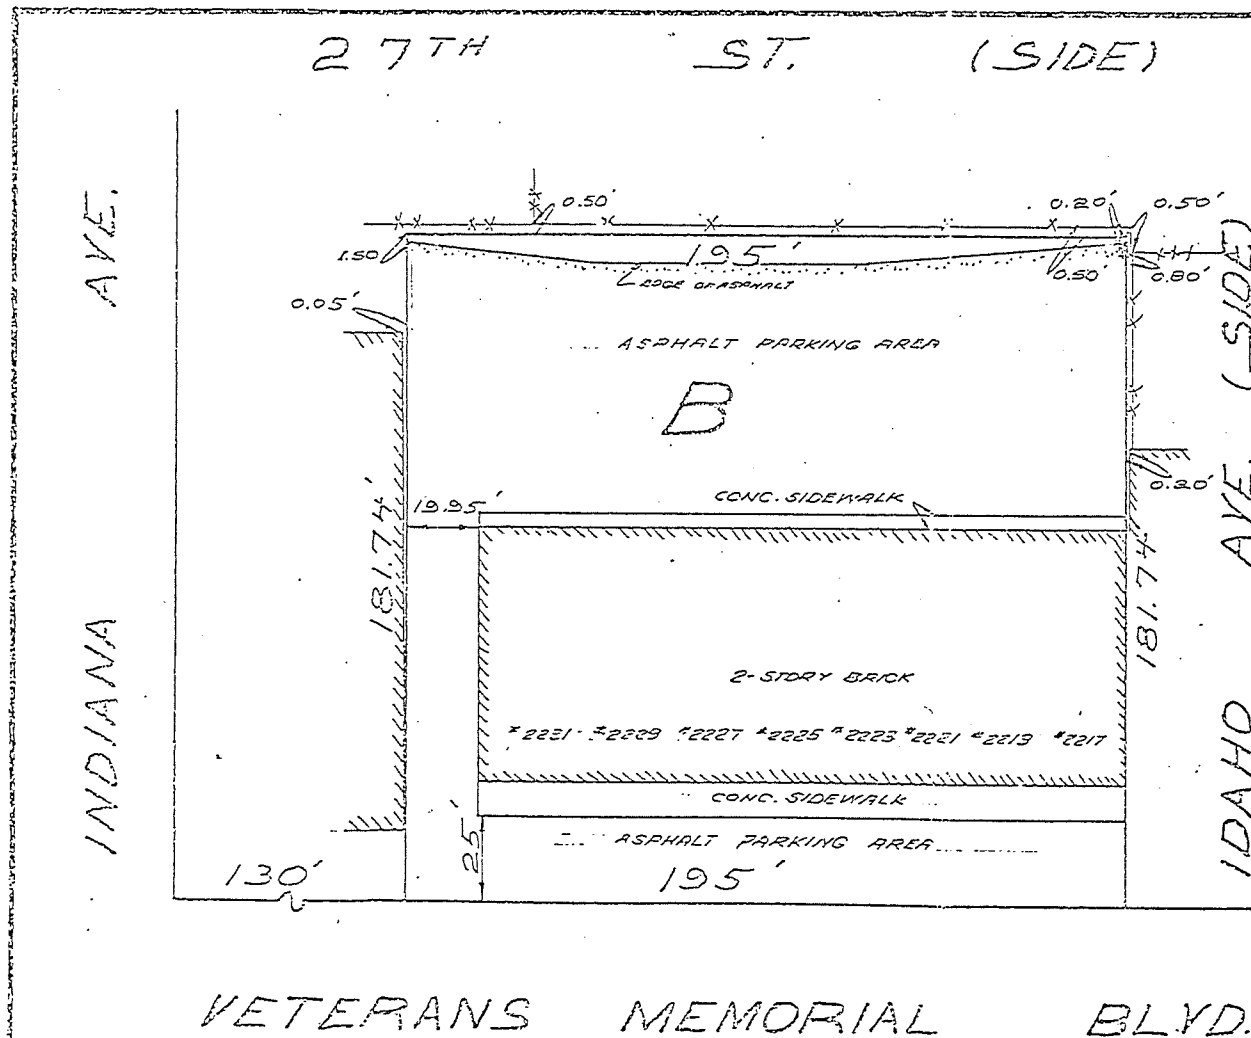

SQ - 329,330
HIGHWAY PARK SUE
KENNER
JEFFERSON PARISH, L.

0 = IRON ROD

METairie, LA. OCTOBER 25, 197

RESURVEYED AT THE REQUEST OF
JONES, WALKER, WRECHTER, POITEVIN,
CARRERE, & DENESQUE FOR THE
ACCOUNT OF #0504 (EUP. AC I) AN.
LAWRENCE EUSTIS MORTGAGE COR.
TO SHOW IMPROVEMENTS.

CERTIFIED CORR.
J.J. KREBS & SONS.

John J. Krebs

METairie, LA. JUNE 22, 197
SURVEYED MADE AT
THE REQUEST OF LOUIS
G. DUTEL, JR. FOR THE
ACCOUNT OF EDMOND TON
AND CHICAGO TITLE INS.
CO.

CERTIFIED CORRECT
J.J. KREBS & SONS, INC.

John J. Krebs

JOB No. 714755-735529