



woodward design group
 P.O. BOX 13547 NEW ORLEANS, LOUISIANA 70115
 504.822.6449 TEL. WOODWARDDESIGNBUILD.COM

Liberty's Kitchen
 300 N. Broad St.
 New Orleans, Louisiana



job no.
6022-279

drawn by
J. Gautreau


checked by
D. Fant

date AUG 15th, 2013
 for CONSTRUCTION DOCUMENTS
 revisions
 no. for
 MODIFIED January 6, 2014


sheet contents
 FLOOR PLAN AND
 F.F.E. PLAN

A101

Note: If any items herein are not understandable or clear as to intent, contractor must notify the architect of record for clarification and/or supplemental information prior to actual installation.

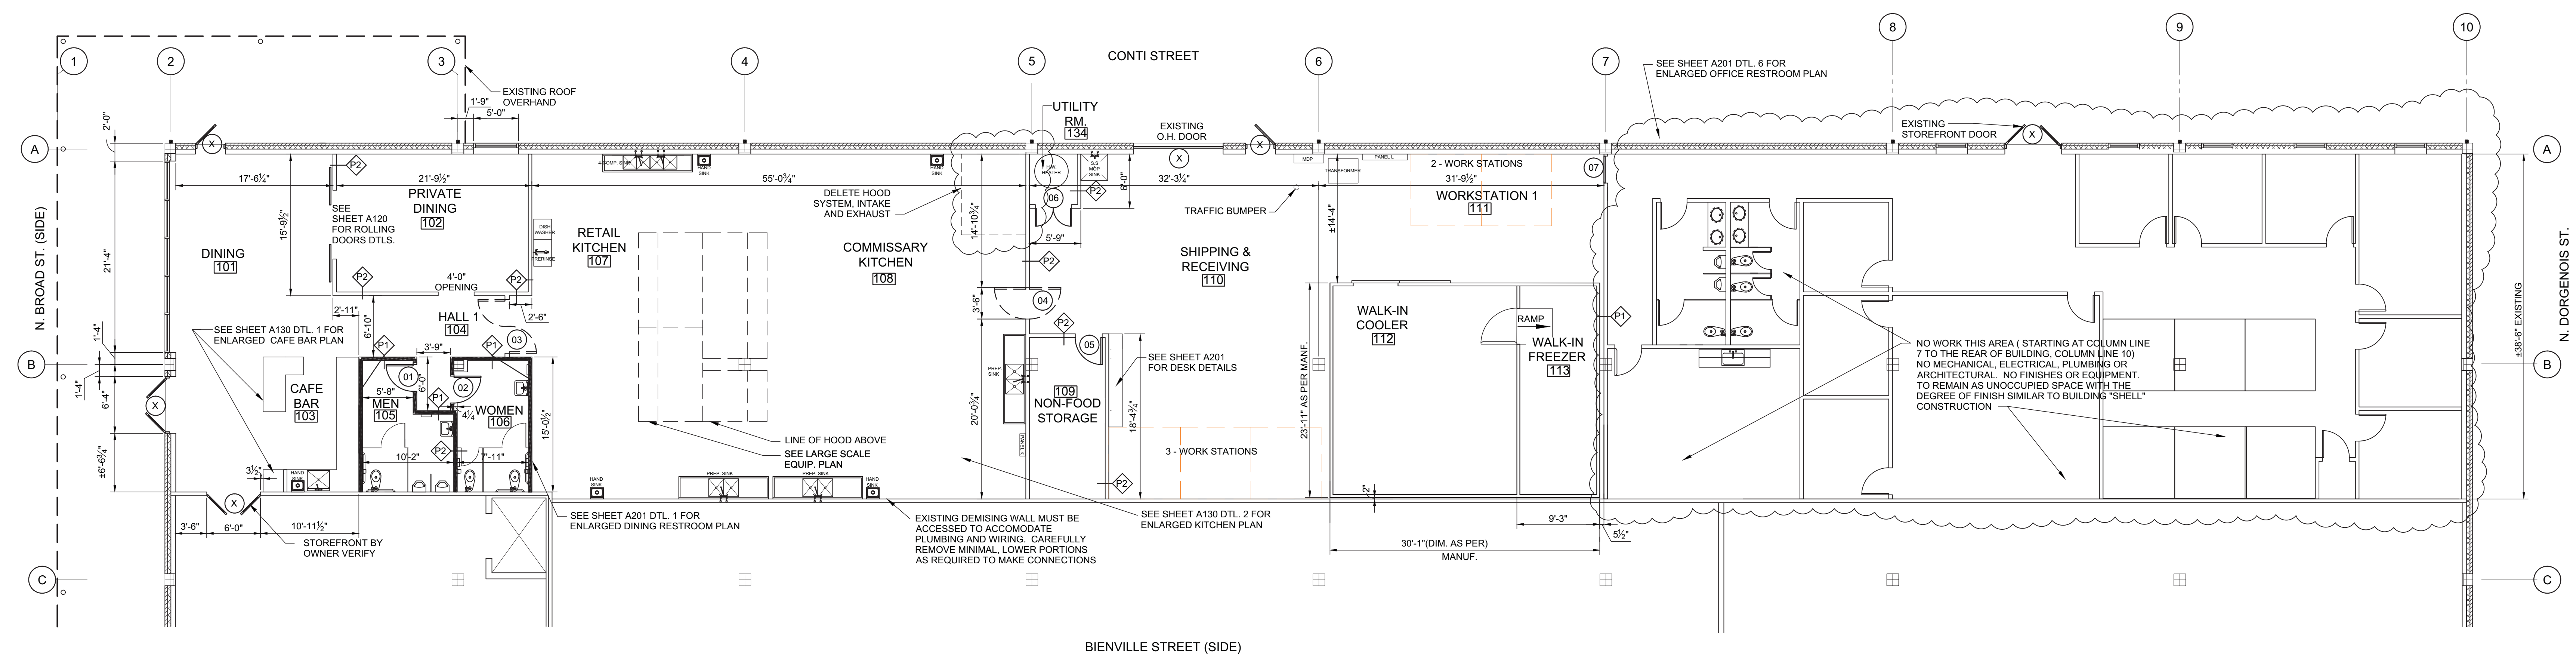

1 FLOOR PLAN
 A101 1/8" = 1'-0"

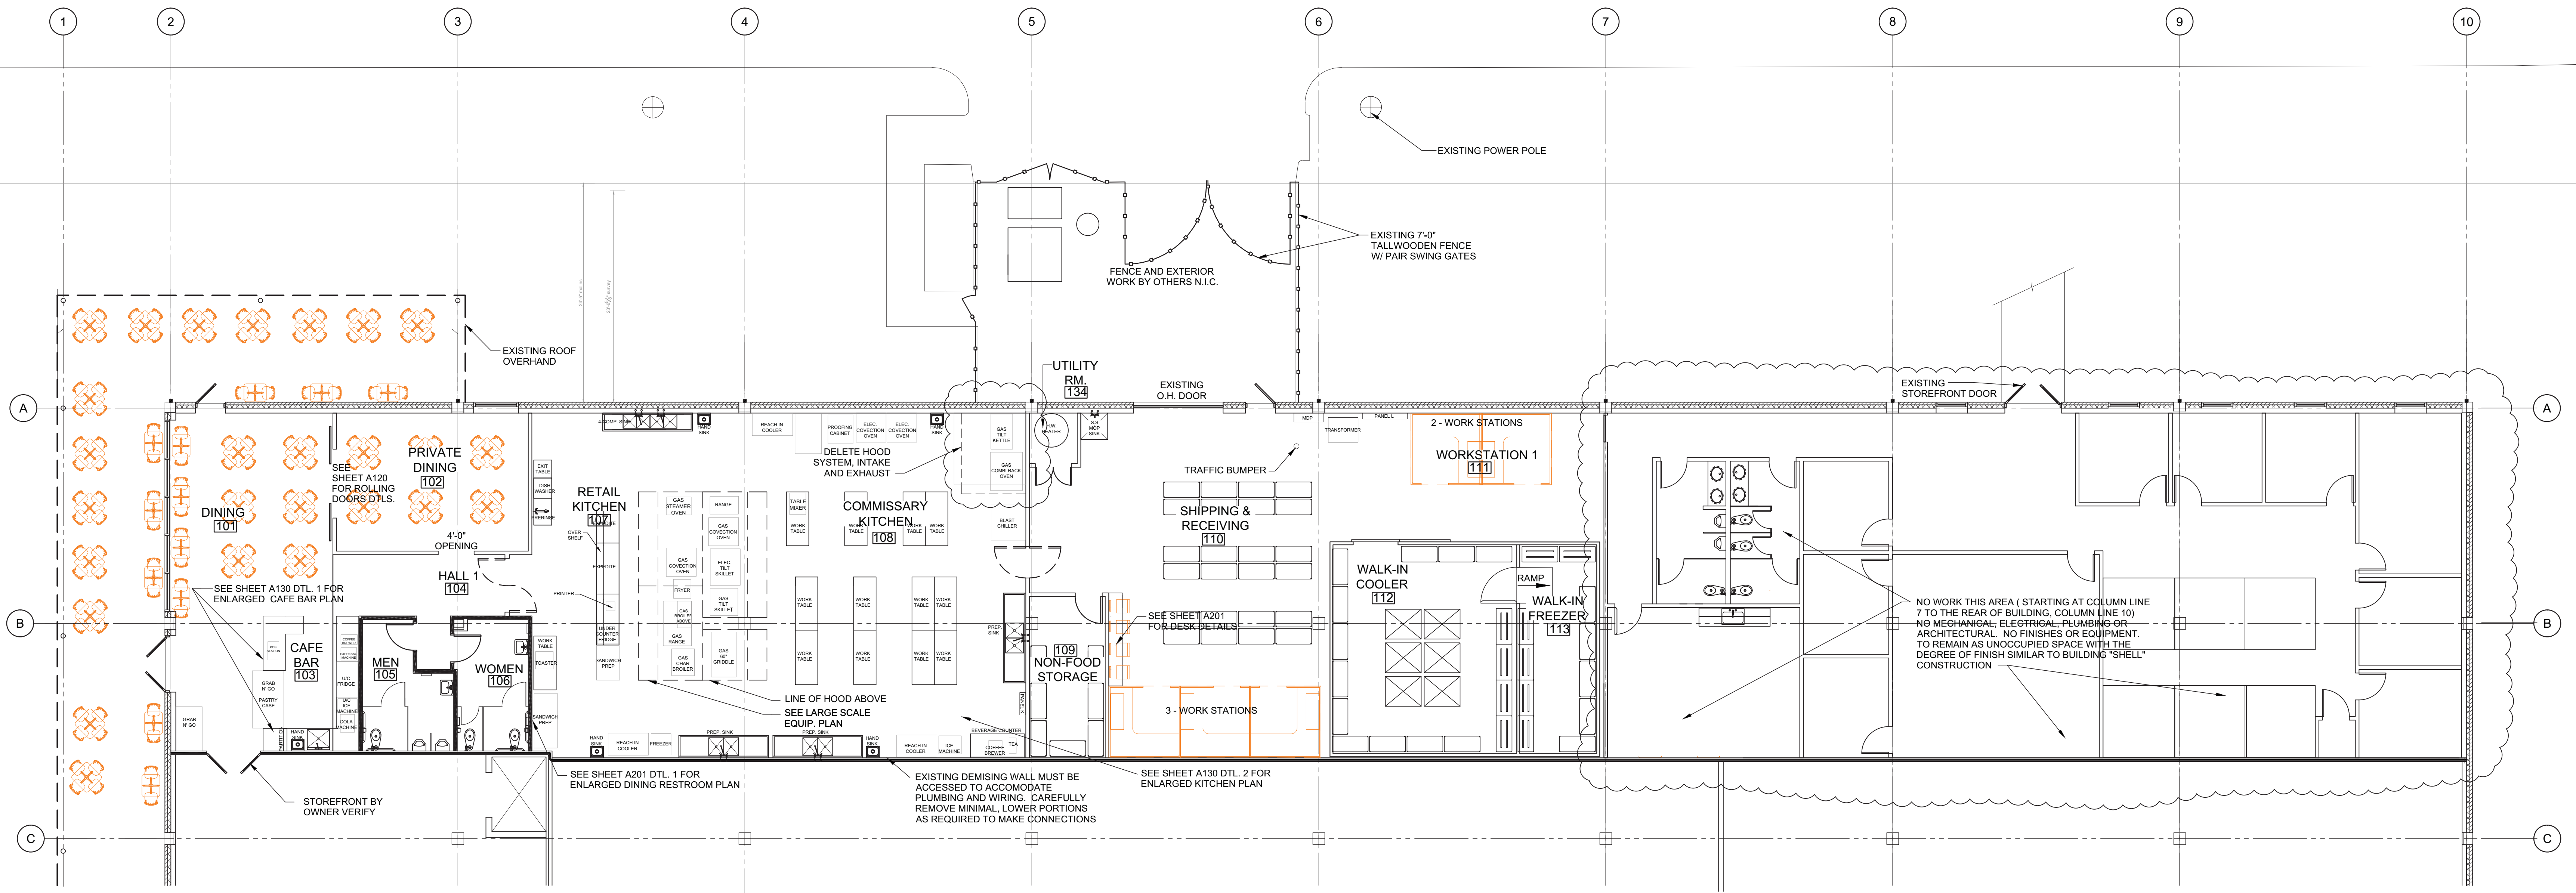

2 FF&E PLAN
 A101 1/8" = 1'-0"