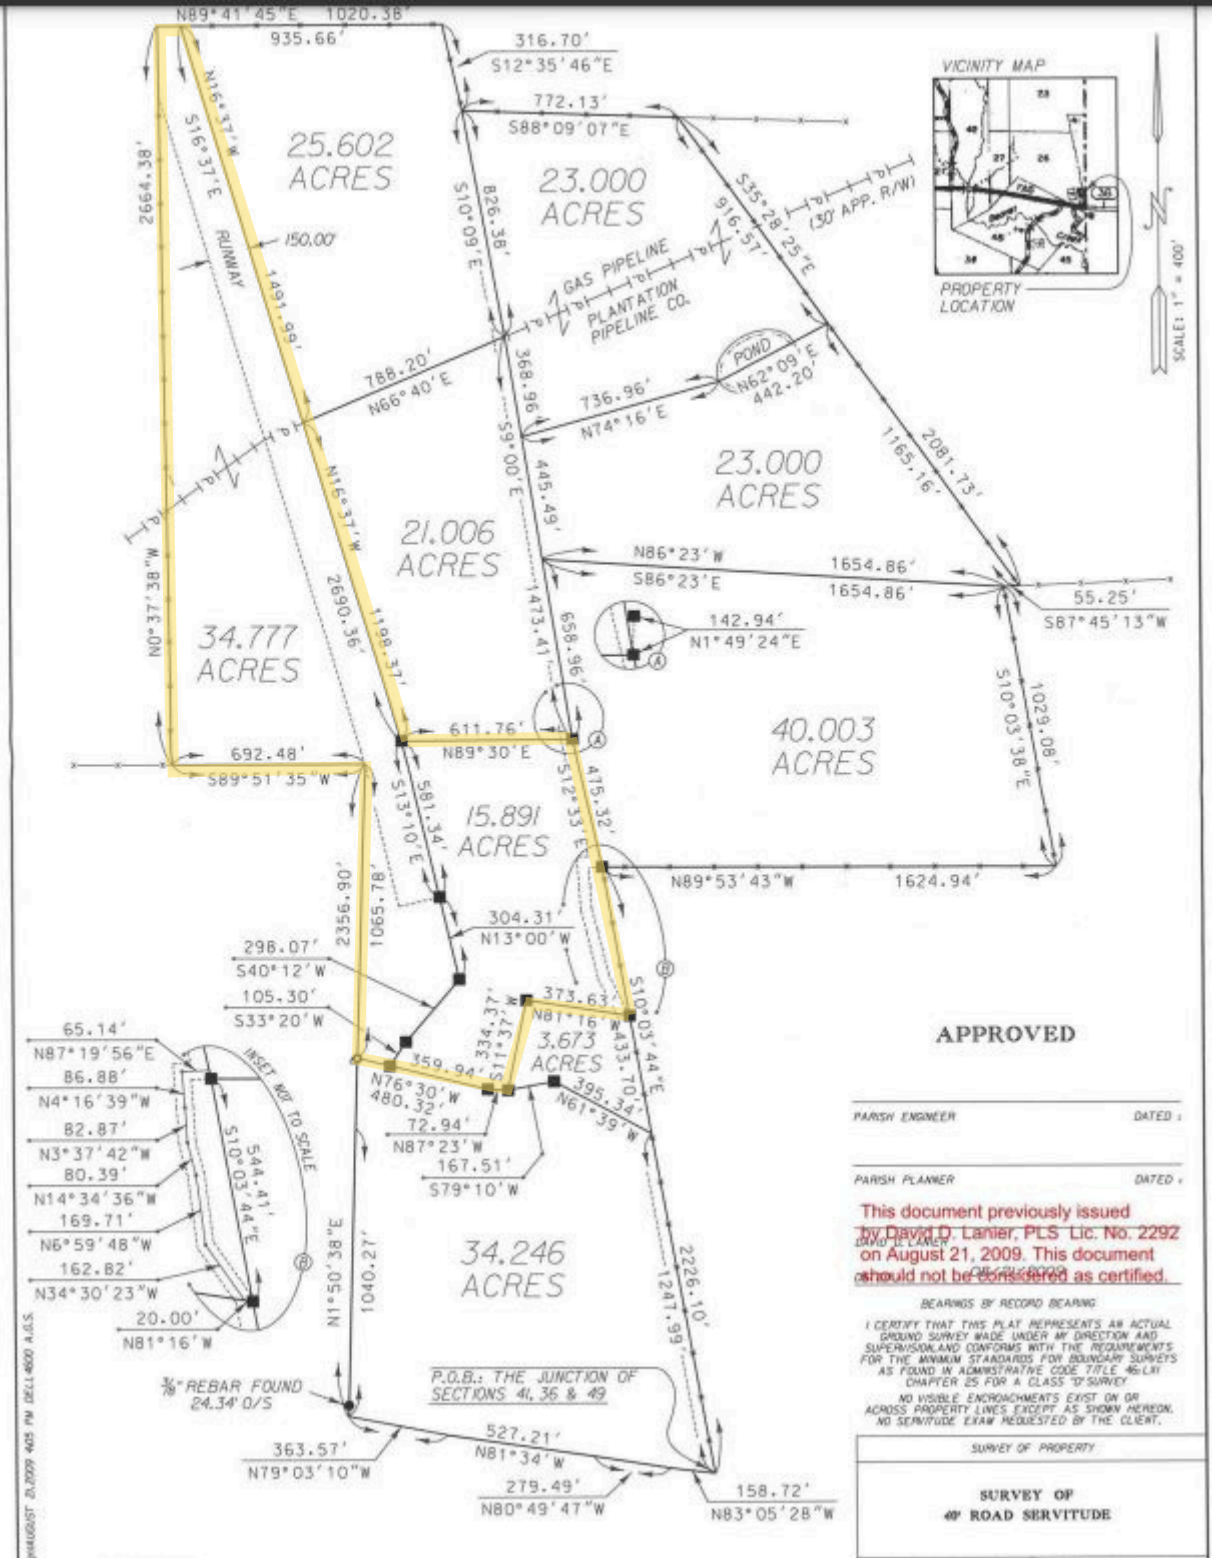
N89°41'45"E 1020.38'
935.66'
316.70'
S12°35'46"E
772.13'
S88°09'07"E
VICINITY MAP
PROPERTY LOCATION
SCALE: 1" = 400'
25.602 ACRES
23.000 ACRES
21.006 ACRES
34.777 ACRES
23.000 ACRES
40.003 ACRES
15.891 ACRES
3.673 ACRES
34.246 ACRES
2664.38'
N16°37'W
S16°37'E
RUNWAY
150.00'
1491.99'
826.38'
S10°09'E
S35°28'25"E
916.57'
(30' APP. R/W)
GAS PIPELINE
PLANTATION PIPELINE CO.
POND
N62°09'E
442.20'
788.20'
N66°40'E
368.96'
736.96'
N74°16'E
S9°00'E
445.49'
1165.16'
2081.73'
N0°37'38"W
N16°37'W
2690.36'
1198.37'
N86°23'W
S86°23'E
1654.86'
1654.86'
55.25'
S87°45'13"W
1473.41'
658.96'
142.94'
N1°49'24"E
611.76'
N89°30'E
692.48'
S89°51'35"W
581.34'
S13°10'E
512°33'E
475.32'
1029.08'
S10°03'38"E
N89°53'43"W
1624.94'
2356.90'
1065.78'
304.31'
N13°00'W
298.07'
S40°12'W
105.30'
S33°20'W
373.63'
N81°16'W
433.70'
S10°03'44"E
334.37'
S11°37'
359.94'
N76°30'W
480.32'
395.34'
N61°39'W
72.94'
N87°23'W
167.51'
S79°10'W
65.14'
N87°19'56"E
86.88'
N4°16'39"W
82.87'
N3°37'42"W
80.39'
N14°34'36"W
169.71'
N6°59'48"W
162.82'
N34°30'23"W
20.00'
N81°16'W
INSET NOT TO SCALE
544.41'
S10°03'44"E
1040.27'
N1°50'38"E
2226.10'
1247.99'
3/8" REBAR FOUND 24.34' O/S
P.O.B.: THE JUNCTION OF SECTIONS 41, 36 & 49
527.21'
N81°34'W
363.57'
N79°03'10"W
279.49'
N80°49'47"W
158.72'
N83°05'28"W
APPROVED
PARISH ENGINEER
DATED :
PARISH PLANNER
DATED :
This document previously issued by David D. Lanier, PLS Lic. No. 2292 on August 21, 2009. This document should not be considered as certified.
DAVID D. LANIER
BEARINGS BY RECORD BEARING
I CERTIFY THAT THIS PLAT REPRESENTS AN ACTUAL GROUND SURVEY MADE UNDER MY DIRECTION AND SUPERVISION AND CONFORMS WITH THE REQUIREMENTS FOR THE MINIMUM STANDARDS FOR BOUNDARY SURVEYS AS FOUND IN ADMINISTRATIVE CODE TITLE 46 LAI CHAPTER 25 FOR A CLASS "D" SURVEY
NO VISIBLE ENCROACHMENTS EXIST ON OR ACROSS PROPERTY LINES EXCEPT AS SHOWN HEREON. NO SERVITUDE EXAM REQUESTED BY THE CLIENT.
SURVEY OF PROPERTY
SURVEY OF
40' ROAD SERVITUDE