


BOUNDARY SURVEY OF
LOT 10-A-2
SQUARE 156 & 157
HARLEM
JEFFERSON PARISH, LA

EAST BOUNDARY OF HARLEM (SIDE)

LEGEND

- Ø POWER POLE
- ⊕ FIRE HYDRANT
- ⊙ SEWER MANHOLE
- ⊙ WATER MANHOLE
- ⊞ ELECTRIC BOX
- ⊞ DRAIN INLET

SUNDORN STREET (SIDE)

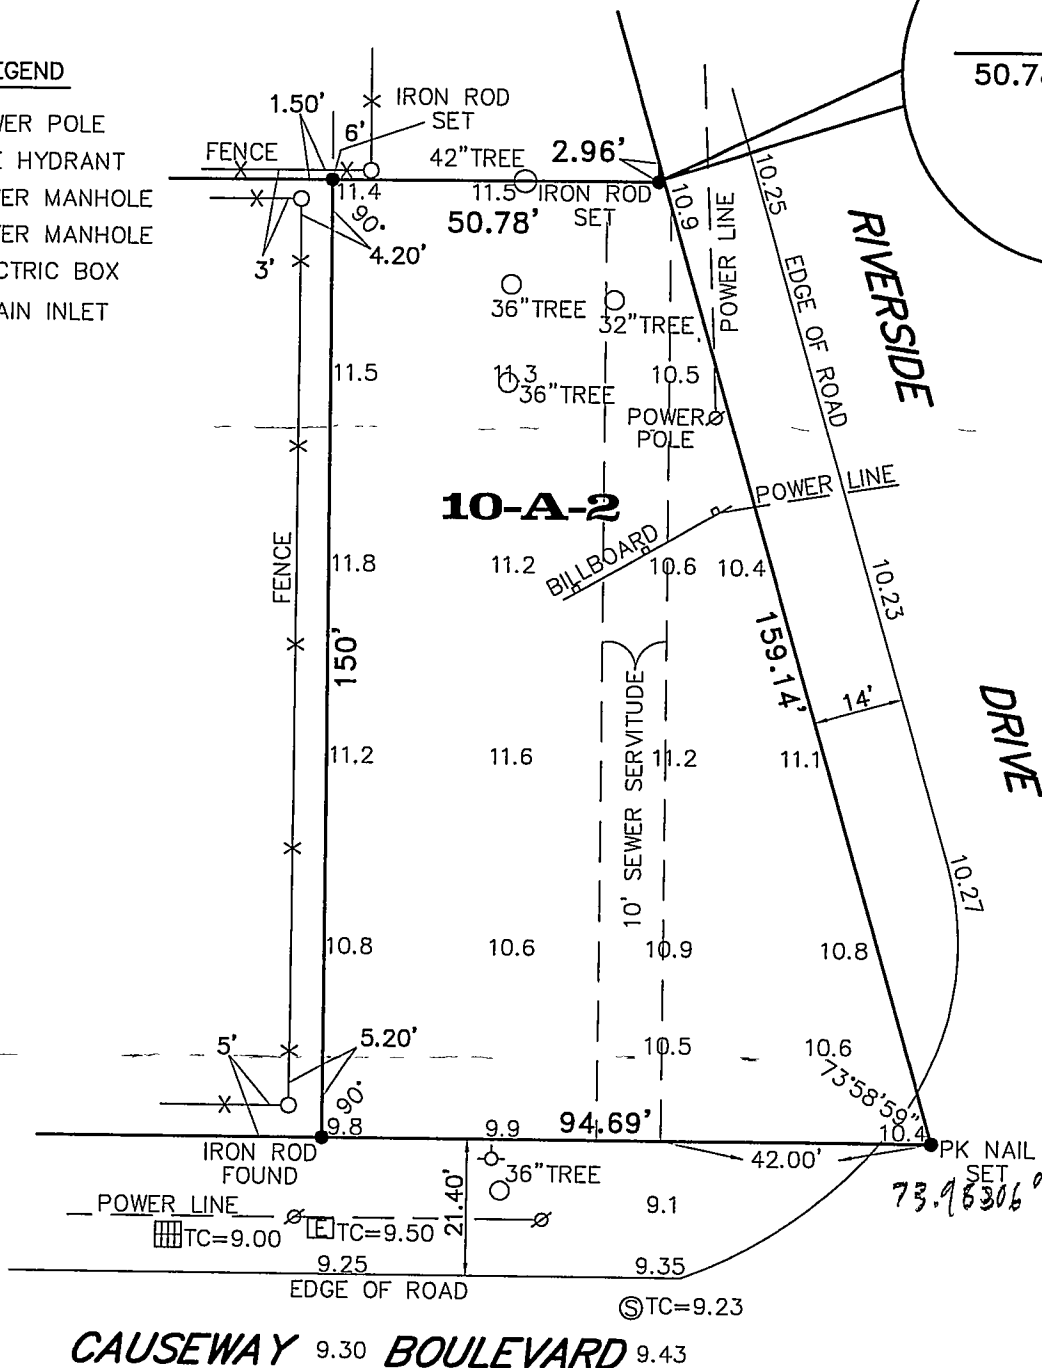

CAUSEWAY 9.30 BOULEVARD 9.43

NOTE:

ALL ANGLES ARE 90° UNLESS OTHERWISE NOTED. SOME ITEMS MAY NOT BE TO SCALE FOR CLARITY. DIMENSIONS ON SURVEY PREVAIL OVER THE SCALE. FENCES ARE SHOWN FOR GENERAL INFORMATION PURPOSES ONLY AND DO NOT REFLECT EXACT LOCATION OR CONDITION.

GENERAL NOTES

ANGLES AND/OR BEARINGS ARE BASED ON REFERENCE PLAN #1
REFERENCE PLAN #1: A PLAN OF SURVEY BY J. J. KREBS & SONS, INC. DATED JULY 25, 1978

THE SERVITUDES SHOWN ON THIS SURVEY ARE LIMITED TO THOSE FURNISHED US AND THERE IS NO REPRESENTATION THAT ALL APPLICABLE SERVITUDES ARE REFLECTED OR SHOWN HEREON. THE SURVEYOR HAS MADE NO TITLE SEARCH OR PUBLIC RECORD SEARCH IN COMPILING THE DATA FOR THIS SURVEY.

THIS PERIMETER SURVEY SHALL NOT CONSTITUTE A LEGAL OPINION OF TITLE, AND SHALL NOT BE RELIED UPON FOR THAT PURPOSE. THERE IS NO WARRANTY THAT IT CONFORMS TO THE LEGAL TITLE, AND WAS MADE SOLELY ACCORDING TO THE INFORMATION PROVIDED THE SURVEYOR.

ELEVATION NOTES

THIS IS CERTIFY THAT SUBJECT PROPERTY IS LOCATED IN THE FOLLOWING FLOOD ZONE, PER FLOOD INSURANCE RATE MAP (FIRM) DATED: FLOOD ZONE: COMMUNITY PANEL:

THIS IS TO CERTIFY THAT THE PROPERTY BOUNDARY SURVEY RECORDED HEREON WAS MADE ON THE GROUND UNDER MY DIRECT SUPERVISION, AND IS IN ACCORDANCE WITH APPLICABLE STANDARDS OF PRACTICE FOR PROFESSIONAL LAND SURVEYORS AS STIPULATED IN LOUISIANA ADMINISTRATIVE CODE TITLE: 46:XXI, CHAPTER 25 FOR A CLASS "C" (SUBURBAN) SURVEY

MADE AT THE REQUEST OF MARK GRAFFAGNINI
REVISED TO ADD SEWER SERVITUDE MARCH 17, 2015

BY:

Richmond W. Krebs

R. W. KREBS, L.L.C.
RICHMOND W. KREBS
PROFESSIONAL LAND SURVEYING
3445 N. CAUSEWAY BLVD. SUITE 201
METAIRIE, LA. 70002
PHONE: (504) 889-9616
FAX: (504) 889-0916
E-MAIL: richmond@rwkrebs.com
WEB: www.rwkrebs.com

DATE: JANUARY 8, 2015

DRAWN BY: WRB

SCALE: 1" = 30'

CHECKED BY:

JOB #: 143666

COPYRIGHT © 2007
ALL RIGHTS RESERVED
R.W. KREBS, LLC