


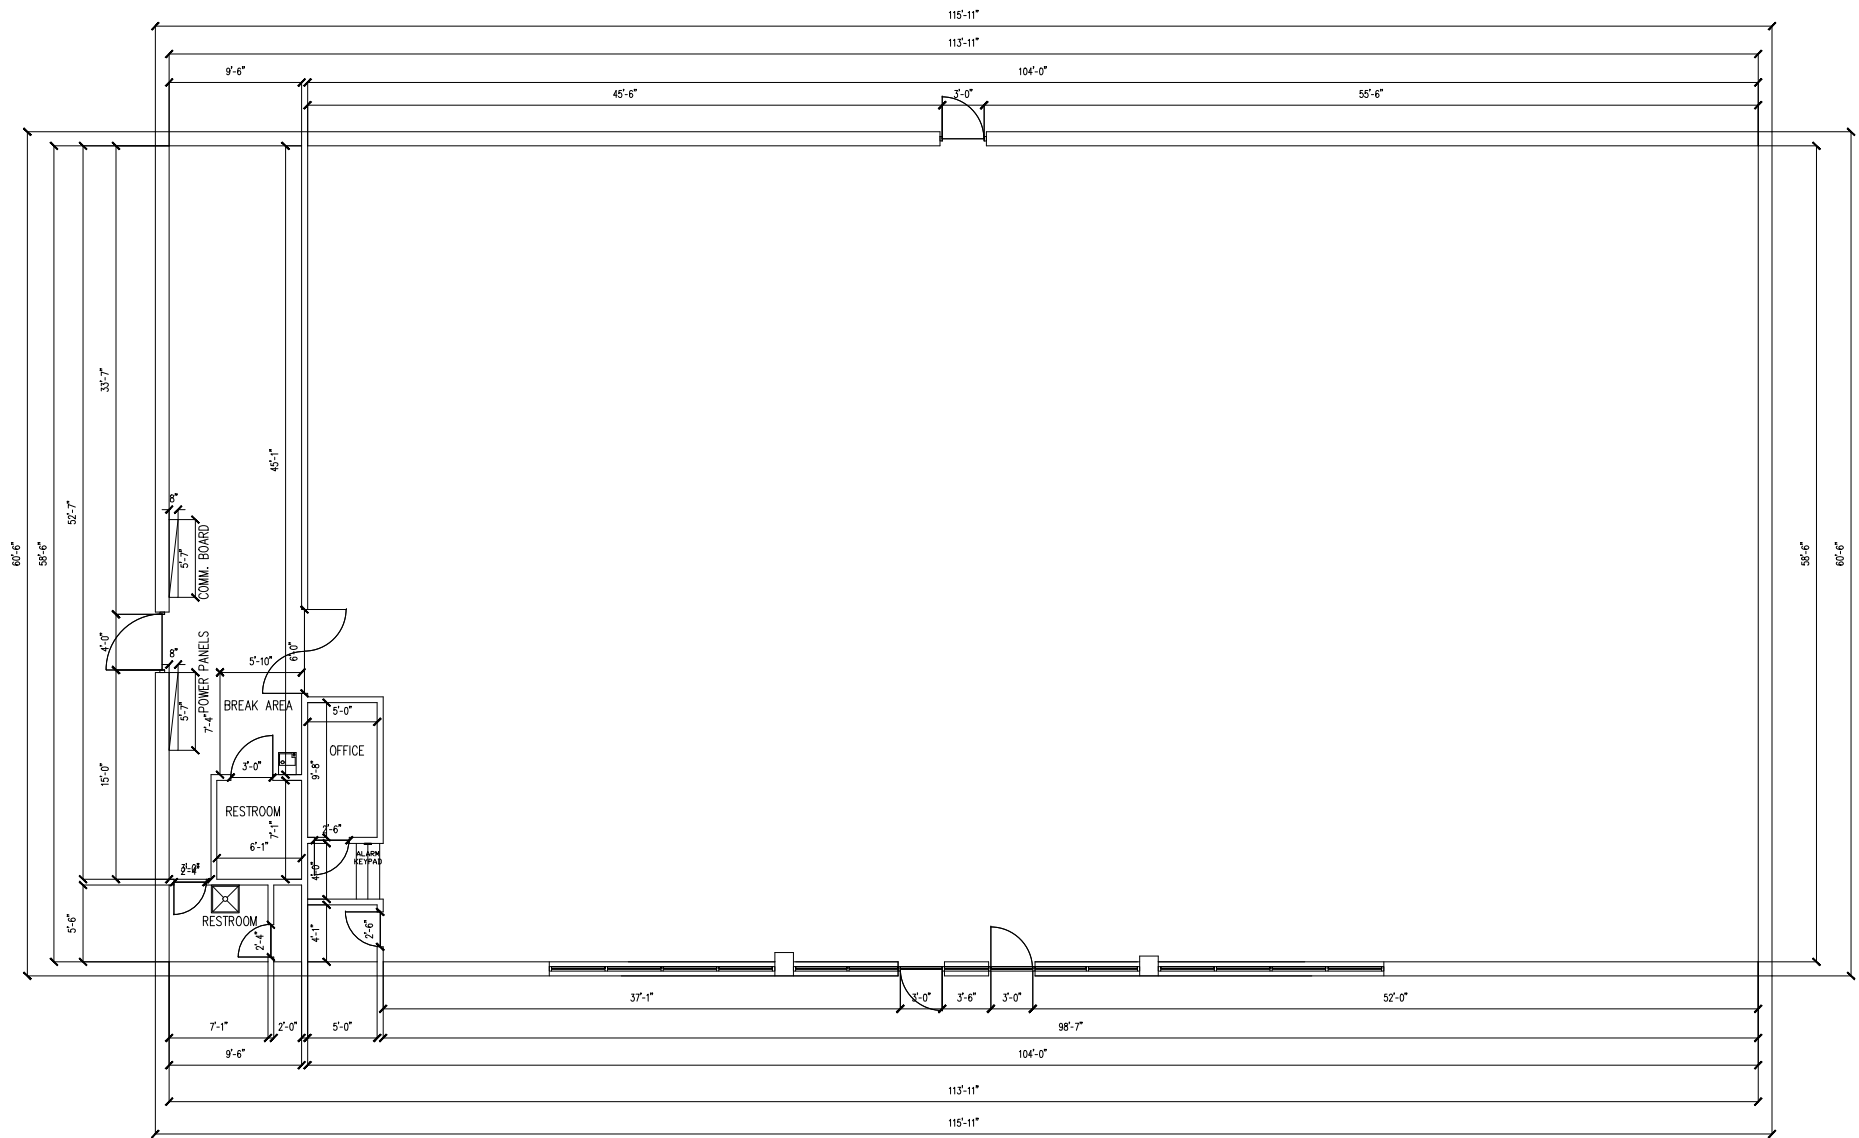

KNEE WALL @ 2'-0" A.F.F.
GLASS TO 8'-8" ABOVE KNEE WALL

STORE NUMBER	LOCATION	TOTAL SQ FT	SALES SQ FT	USABLE STOCK SQ FT	CEILING HEIGHT	SECTION COUNT			DATE DRAWN		SURVEY PLAN		REVISIONS			
											SENIOR PROJECT SUPERVISOR: ANY QUESTIONS CONCERNING FIXTURES AND/OR ADJACENCIES PLEASE EMAIL: PMISSUES@FAMILYDOLLAR.COM		DRAWN BY – DESCRIPTION – DATE			
01488	SHREVEPORT, LA	7,013	5,980	380	10'-7"	XXX			10/11/2021	CONFIDENTIAL - FAMILY DOLLAR USE ONLY						