


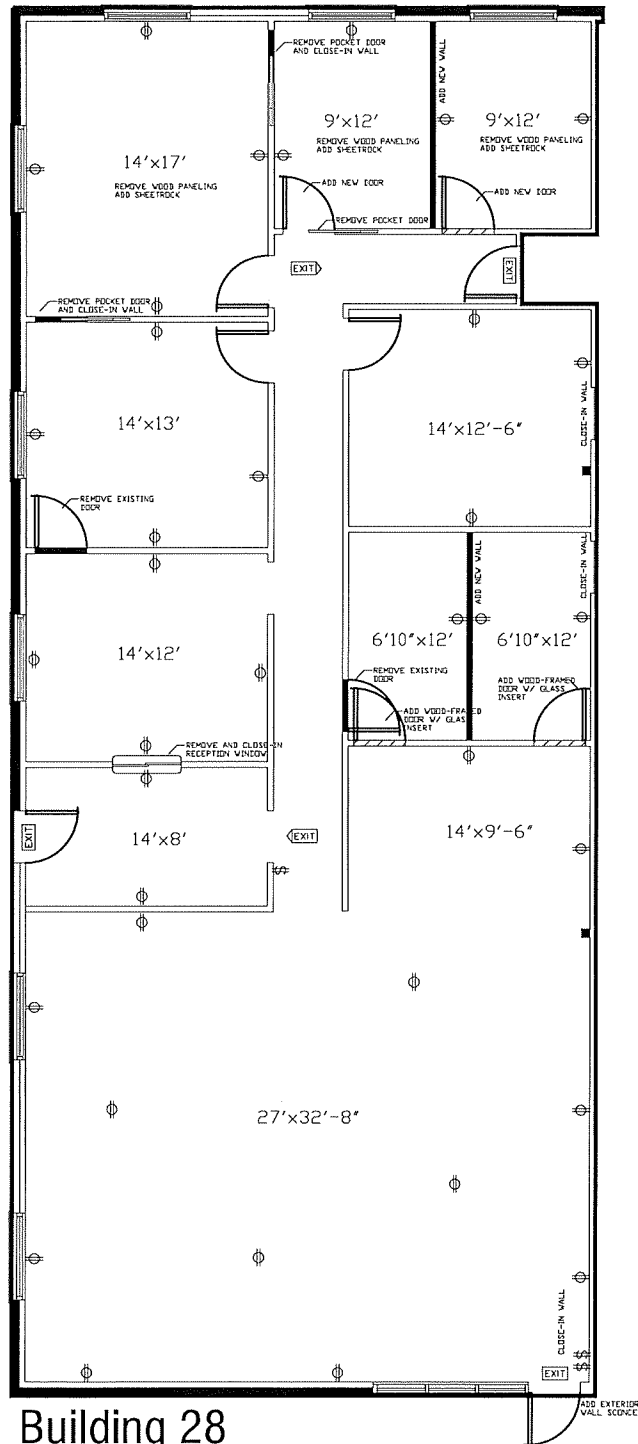

Building 28
Suite 100 2,978 SqFt