


Sq. No. 28, GENTILLY INDUSTRIAL DISTRICT  
THIRD DISTRICT ORLEANS PARISH  
NEW ORLEANS, LA.

ALMONASTER AVE.

LOUISA ST.  
(Formerly Piety)

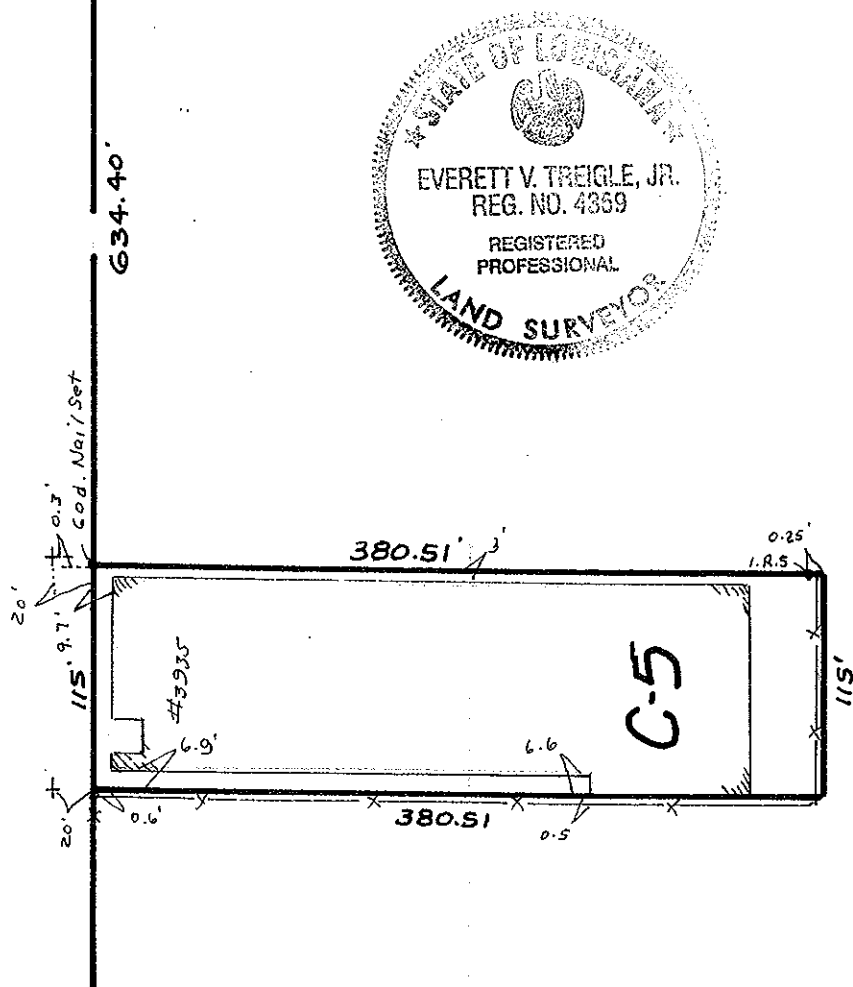

II.

DESIRE ST. SIDE

CHICASAW ST. SIDE

THE SERVITUDES SHOWN ON THIS PLAT ARE LIMITED TO THOSE FURNISHED TO US. THERE IS NO REPRESENTATION THAT ALL APPLICABLE SERVITUDES ARE SHOWN HEREON. THE SURVEYOR HAS MADE NO TITLE SEARCH OR PUBLIC RECORD SEARCH IN COMPILING DATA FOR THIS SURVEY.

THE FEDERAL INSURANCE ADMINISTRATION FLOOD HAZARD BOUNDARY MAP INDICATES THAT THE ABOVE DESCRIBED PROPERTY IS LOCATED IN FIA ZONE

Lot Angles are 90° per plan

Date: Oct. 10, 2002

Scale: 1" = 100'

This plat represents an actual ground survey made by me or under my direct supervision and control and meets the requirements for the Minimum Standards for Property Boundary Surveys as found in Louisiana Administrative Code TITLE 46:LXI, Chapter 25 for a Class "C" survey.

Made at the request of Bonny Babin, wife of and Robert S. Maloney, Whitney National Bank and First American Title Insurance Company

Gilbert, Kelly & Couturie, Inc., Surveying & Engineering  
2121 N. Causeway Blvd., Metairie LA 70001 (504) 836-2121

*Everett V. Treigle, Jr.*