


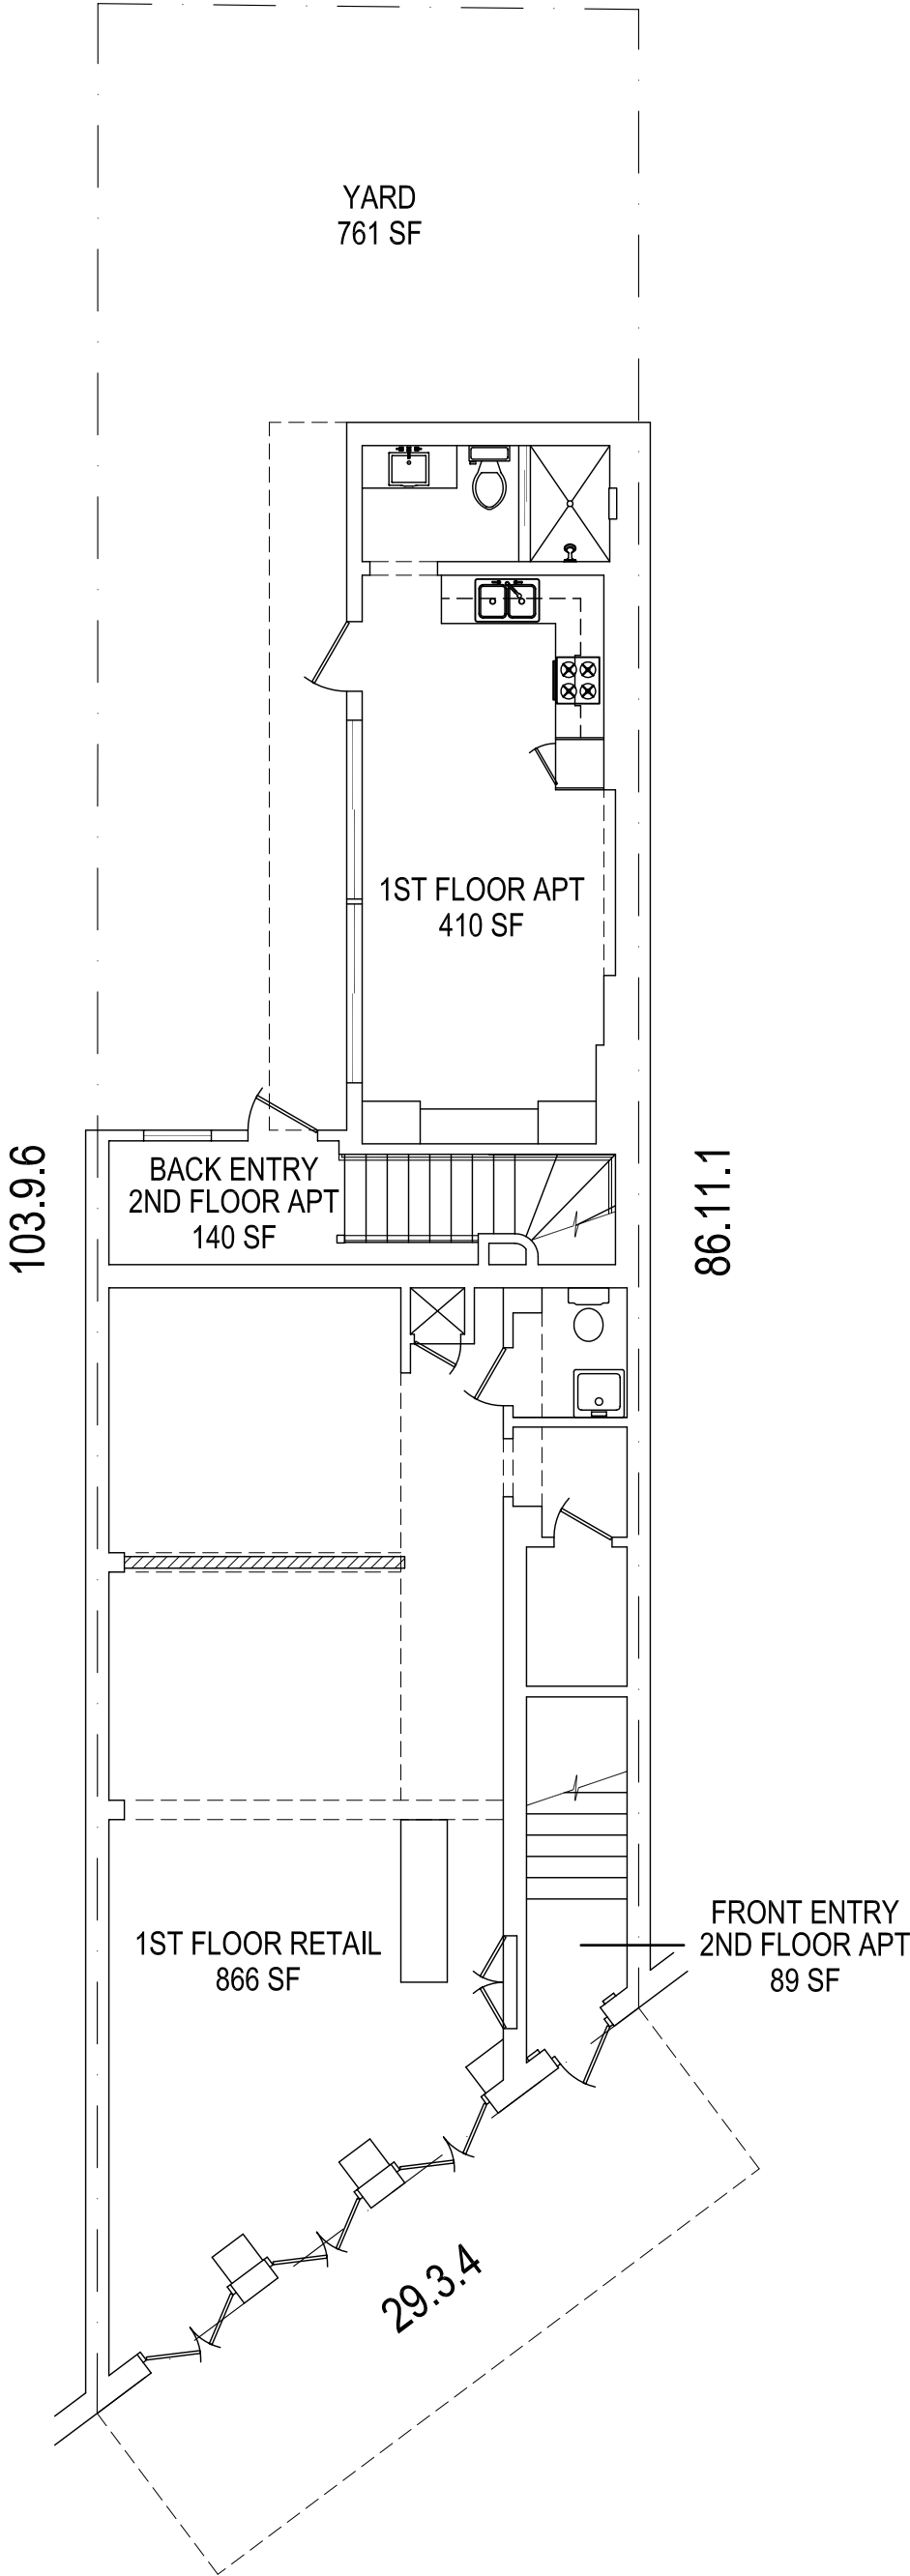

SQUARE FOOTAGE CALCULATIONS ARE APPROXIMATE.
ALL EFFORTS WERE MADE TO FIELD MEASURE UNDER
CURRENT CIRCUMSTANCES AND ACCORDING TO
SITE SURVEY PROVIDED.

EXISTING CONDITIONS PLAN - 1ST FLOOR
1931 - 1933 Sophie Wright Place
New Orleans, Louisiana 70130

SCALE: 1/8"=1'-0"
1931-1933 SOPHIE WRIGHT

DATE: 07-12-2021
REVISED:

DRAWING
EC-1