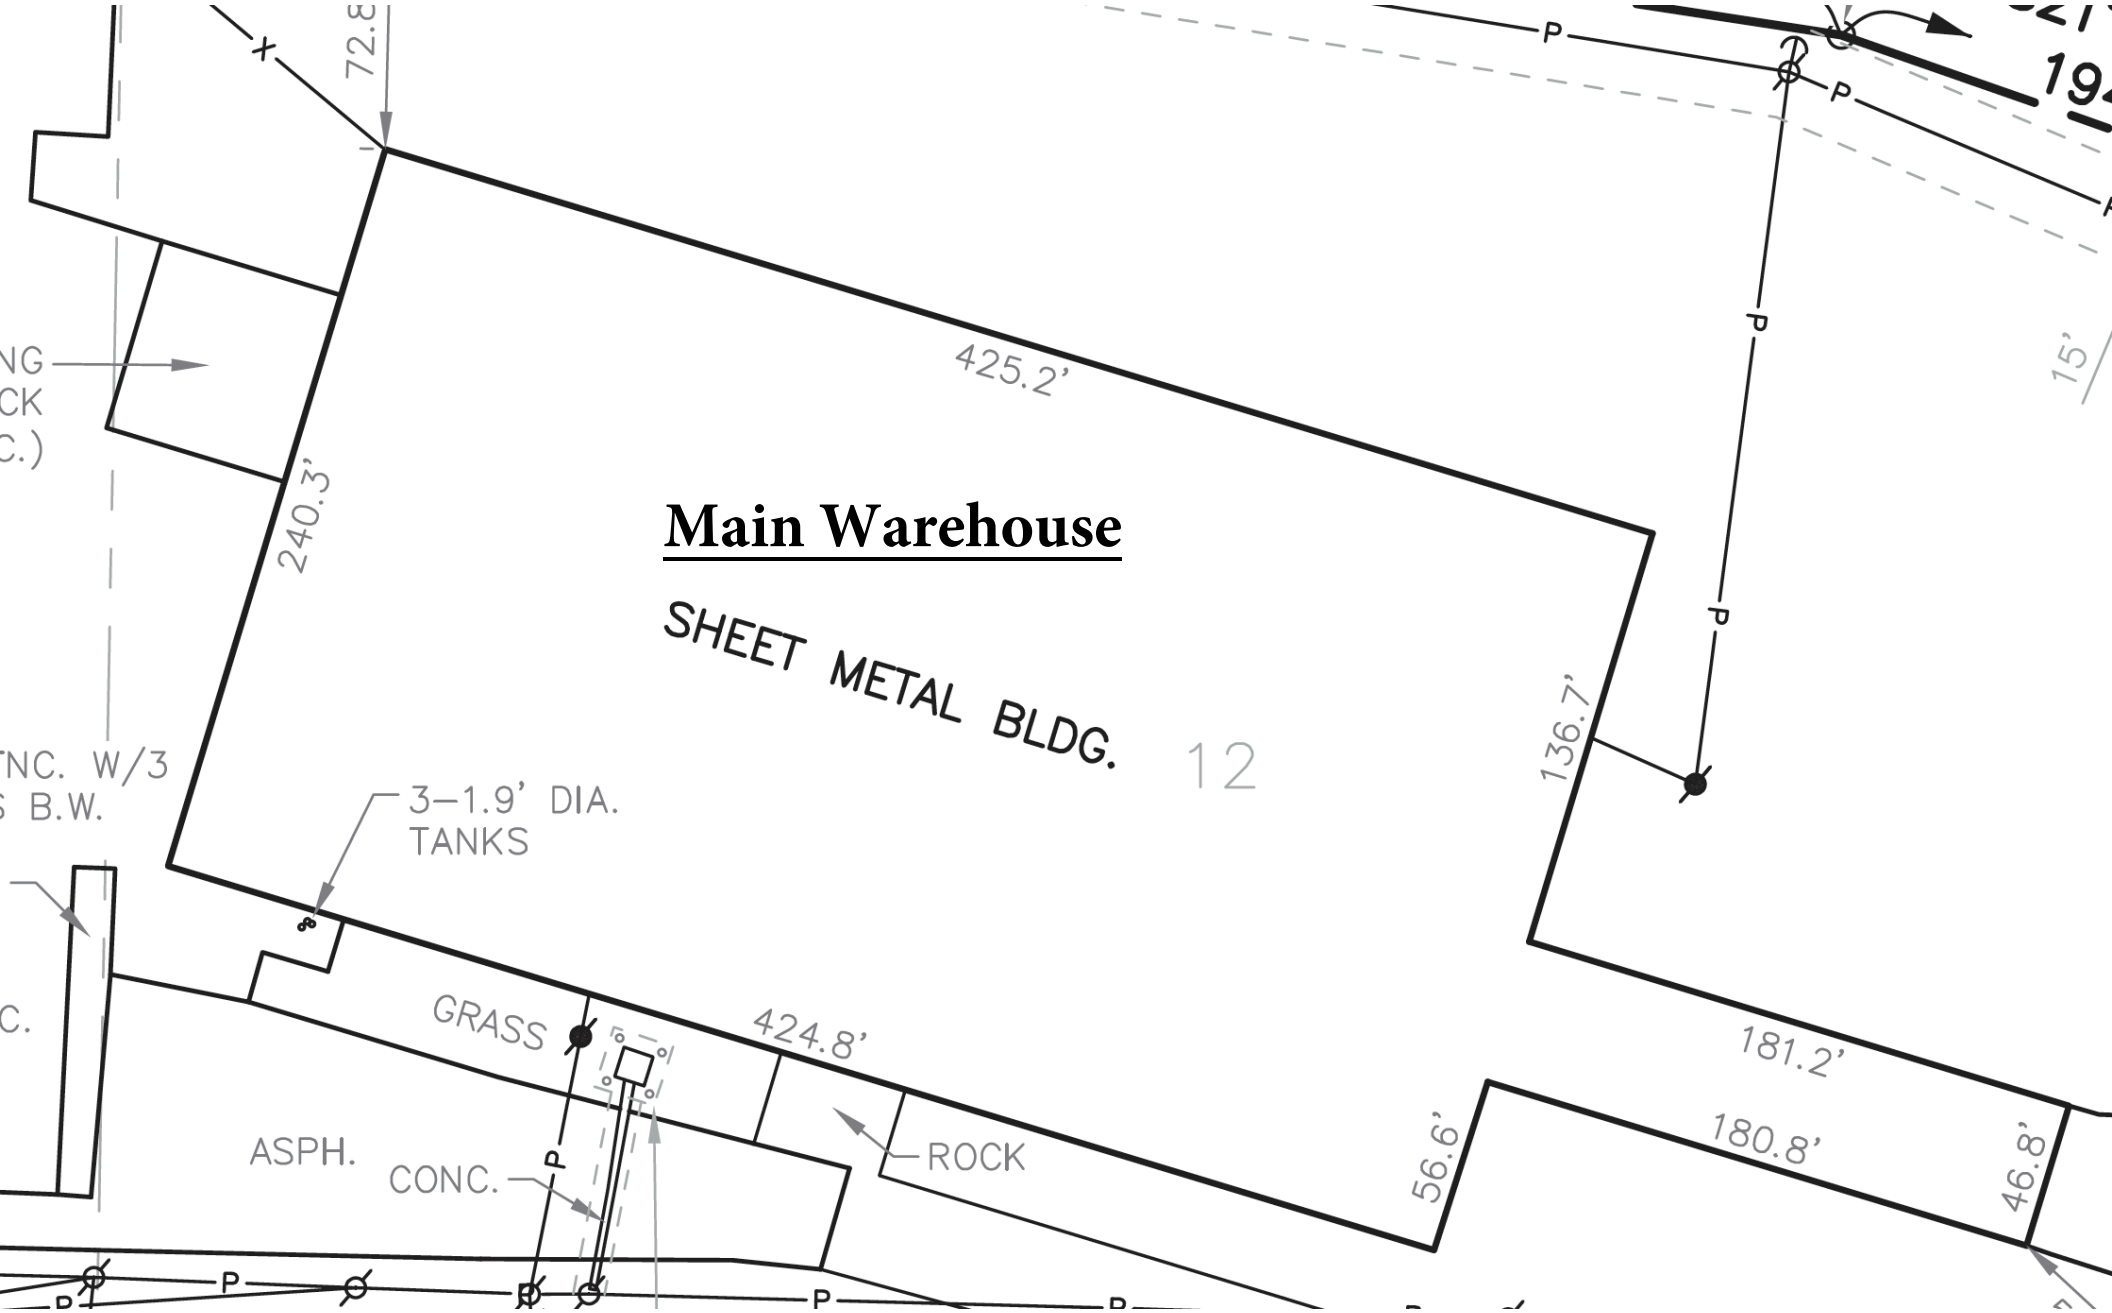
Main Warehouse
SHEET METAL BLDG.
12
425.2'
240.3'
136.7'
181.2'
180.8'
56.6'
46.8'
424.8'
72.8
15'
3–1.9' DIA.
TANKS
GRASS
ASPH.
CONC.
ROCK
P