


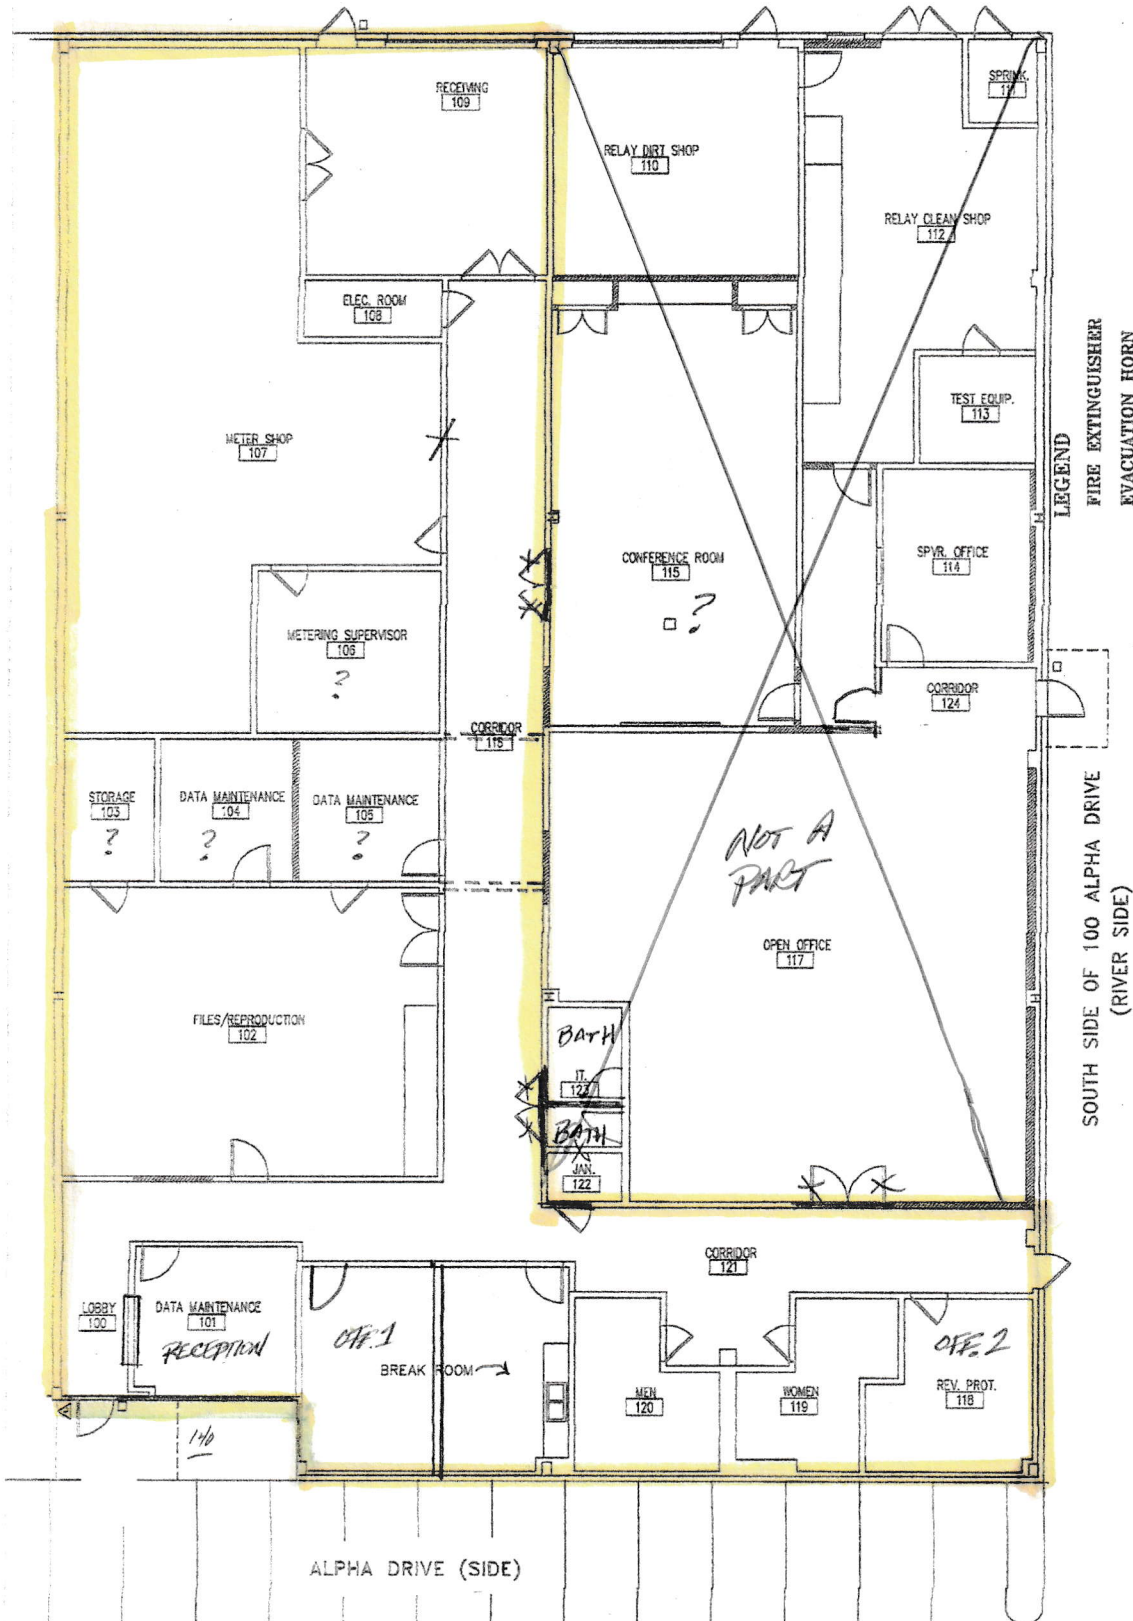

1/16" = 1'

SOUTHERN REGION ENGINEERING
EMERGENCY DISTRESS OFFICE
100 ALPHA DR. SUITE 100
EMERGENCY EVACUATION ROUTE
DATE 04/01/93
ES-03-00000-228



SUITE 102
100 ALPHA DRIVE

5,700 SF

