


JEWELL A ROAD

CRESTWOOD DR.

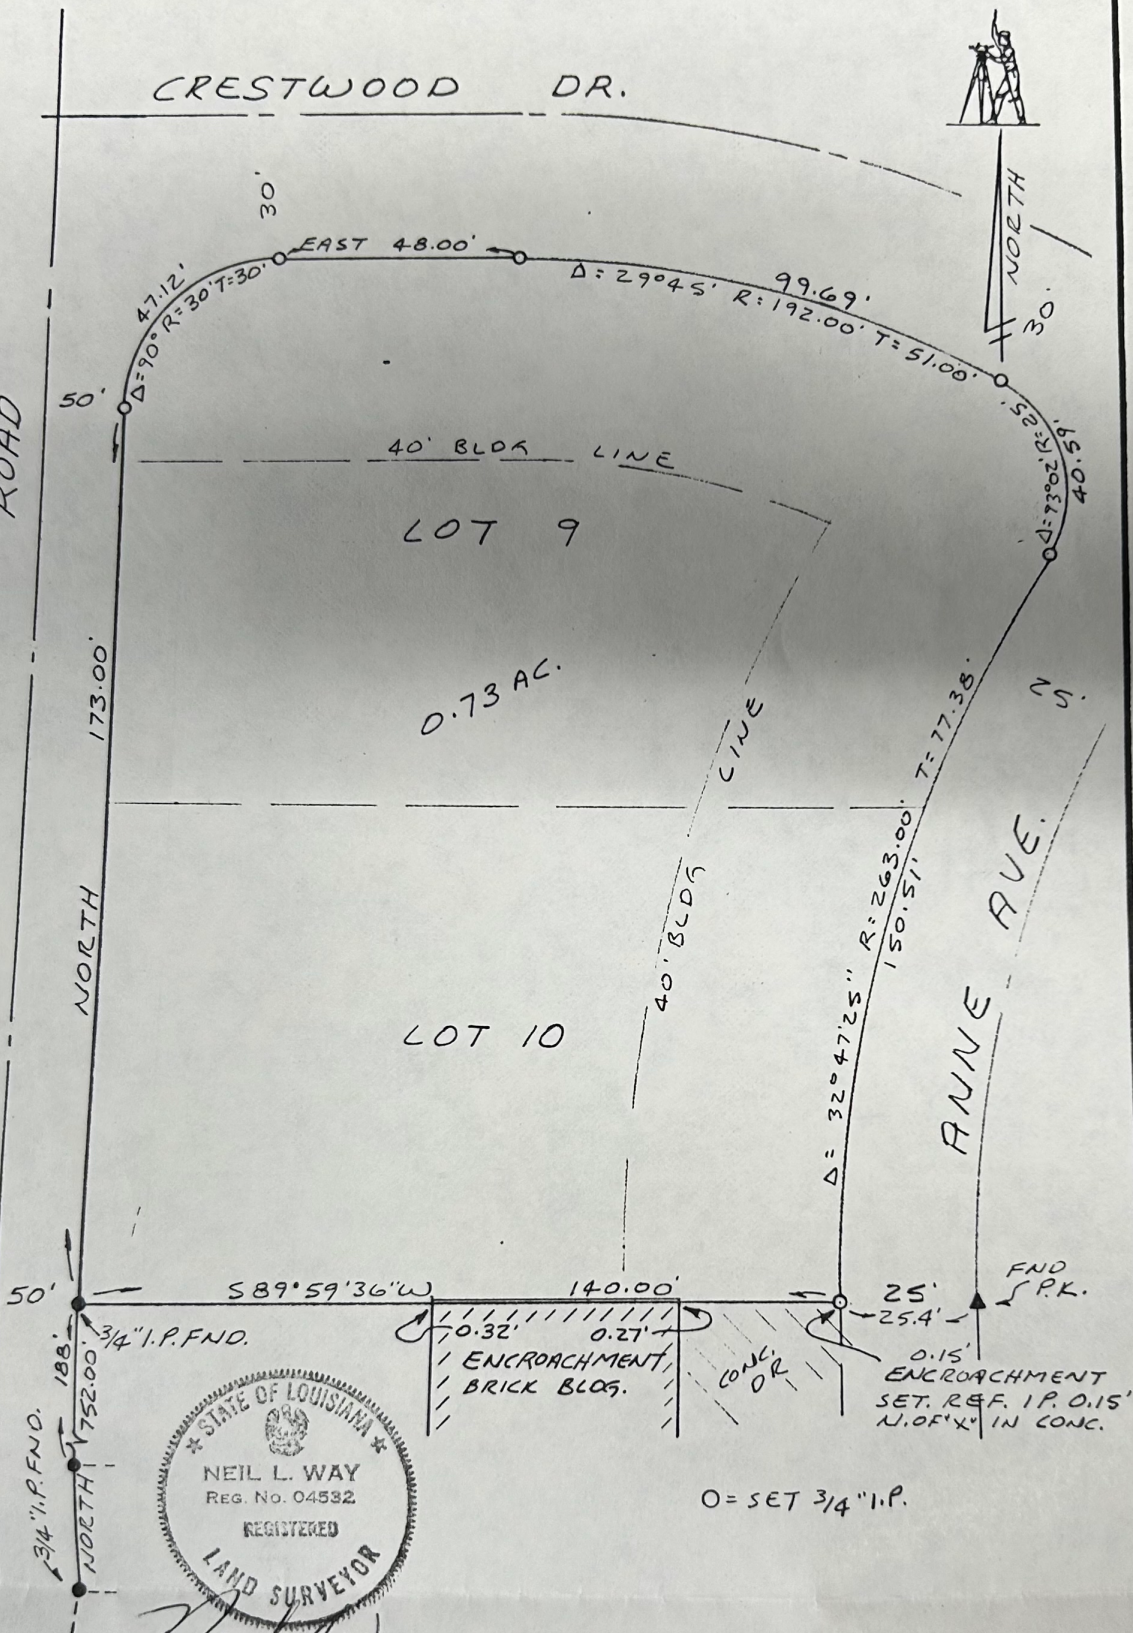

CERTIFICATE OF SURVEY

I NEIL L. WAY HEREBY CERTIFY THAT I HAVE SURVEYED AND MAPPED THE PROPERTY SHOWN HEREON AND THAT THIS PLAT IS A TRUE AND CORRECT REPRESENTATION THEREOF. THIS PLAT IS SUBJECT TO OTHER EASEMENTS OR RESTRICTIONS OF RECORD.

SURVEY OF: Lot 9 and 10 of CRESTWOOD SUBD. being a resub of part of lots 11 to 14 of Oak Grove Subd. Sec. 34 T17N R14W, Caddo Parish Louisiana. Rec B650, P185

SCALE: 1"=30'

PREPARED FOR:

DRAWN N.L.W.

JOB # SU 001

NTB

DATE: 6/15/87

NEIL L. WAY, LAND SURVEYOR

2704 SHED ROAD, SUITE 279 L

BOSSIER CITY, LOUISIANA 71111

PH318-747-2751

BK: 4

PG: 11

DS: test F: 001

SHEET # 1/1