


SQS. 143-152
 HESSMER FARMS
 JEFFERSON PARISH, LA.

872814



HESSMER AVE. (SIDE)

INTERSTATE HWY. 10 (SIDE)

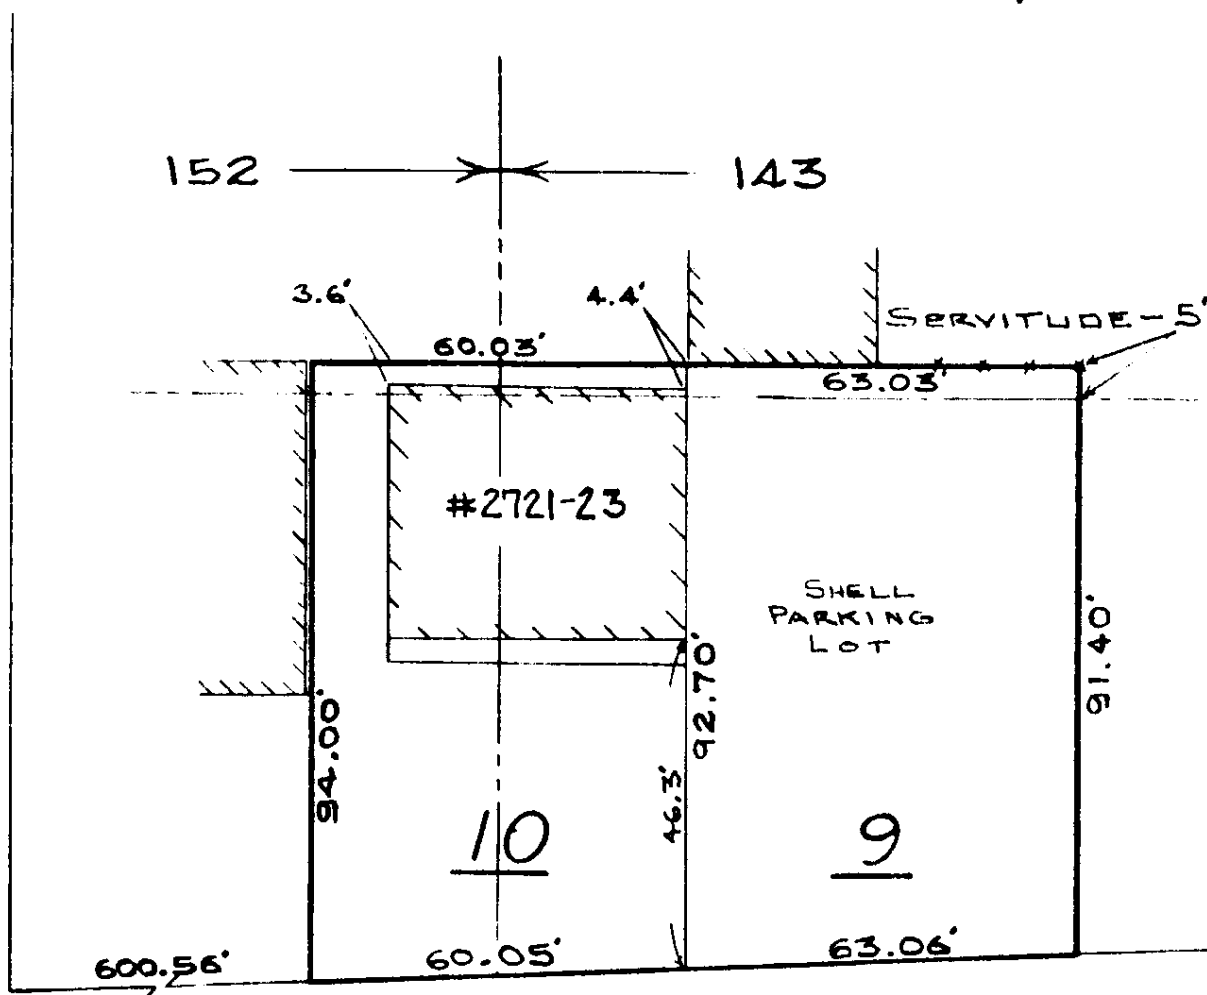

DIVISION

ST.



SURVEY CERTIFIED CORRECT
 MADE AT THE REQUEST OF
 ANDREW M. WEIR, ATTORNEY
 MAR. 12, 1979 *Thomas L. Bernard*

JOB No. 791030 THOMAS L. BERNARD
 LAND SURVEYOR