


DELACHAISE STREET (SIDE)

SQUARE 379
SIXTH DISTRICT
NEW ORLEANS
ORLEANS PARISH, LA.

SCALE: 1"=30'

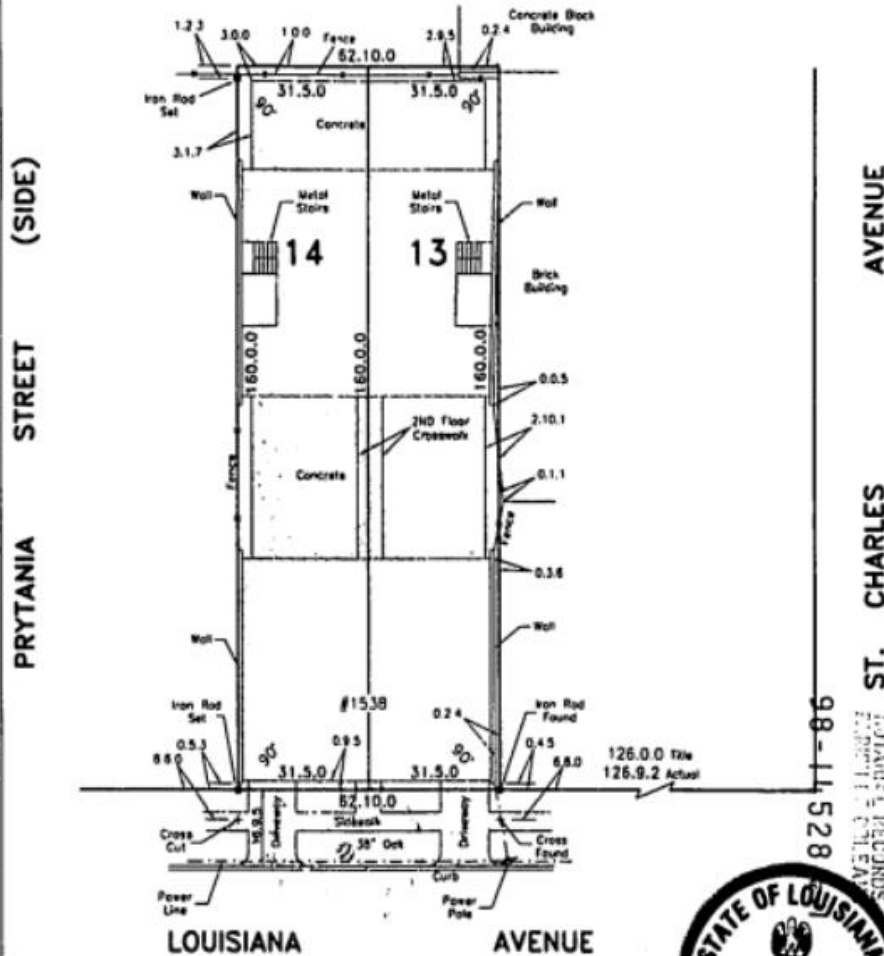

NOTES

THE SERVITUDES SHOWN ON THIS SURVEY ARE LIMITED TO THOSE FURNISHED US AND THERE IS NO REPRESENTATION THAT ALL APPLICABLE SERVITUDES ARE REFLECTED OR SHOWN HEREON. THE SURVEYOR HAS MADE NO TITLE SEARCH OR PUBLIC RECORD SEARCH IN COMPILING THE DATA FOR THIS SURVEY.

THIS PERIMETER SURVEY SHALL NOT CONSTITUTE A LEGAL OPINION OF TITLE, AND SHALL NOT BE RELIED UPON FOR THAT PURPOSE. THERE IS NO WARRANTY THAT IT CONFORMS TO THE LEGAL TITLE, AND WAS MADE SOLELY ACCORDING TO THE INFORMATION PROVIDED THE SURVEYOR.

ANGLES AND/OR BEARINGS ARE BASED ON EXISTING RECORD BEARINGS.

METairie, LA.

FEBRUARY 4, 1998

THIS IS TO CERTIFY TO FIRST AMERICAN TITLE INSURANCE COMPANY, ORLEANS TITLE INSURANCE AGENCY, L.L.C., FRIENDS ALLIANCE FOR THE MENTALLY ILL AND DEPOSIT GUARANTY NATIONAL BANK, THAT THIS MAP OR PLAT AND THE SURVEY ON WHICH IT IS BASED WERE MADE IN ACCORDANCE WITH "MINIMUM STANDARD DETAIL REQUIREMENTS FOR ALTA/ACSM LAND TITLE SURVEYS", JOINTLY ESTABLISHED AND ADOPTED BY ALTA, ACSM AND NSPS IN 1997, AND MEETS THE ACCURACY REQUIREMENTS OF AN URBAN SURVEY, AS DEFINED THEREIN.

Lawrence G. Bodet
LAWRENCE G. BODET
LA REGISTRATION No. 664

KREBS, LeSALLE, LeMIEUX CONSULTANTS, INC.
ENGINEERING • PLANNING • SURVEYING • HYDROLOGY • ENVIRONMENTAL
3013 27TH ST. METairie, LA. 70002 (504)837-9470
2107 N. CAUSEWAY BLVD. SUITE-F WANDERVILLE, LA. 70448 (504)824-5125

JOB No. 980049