



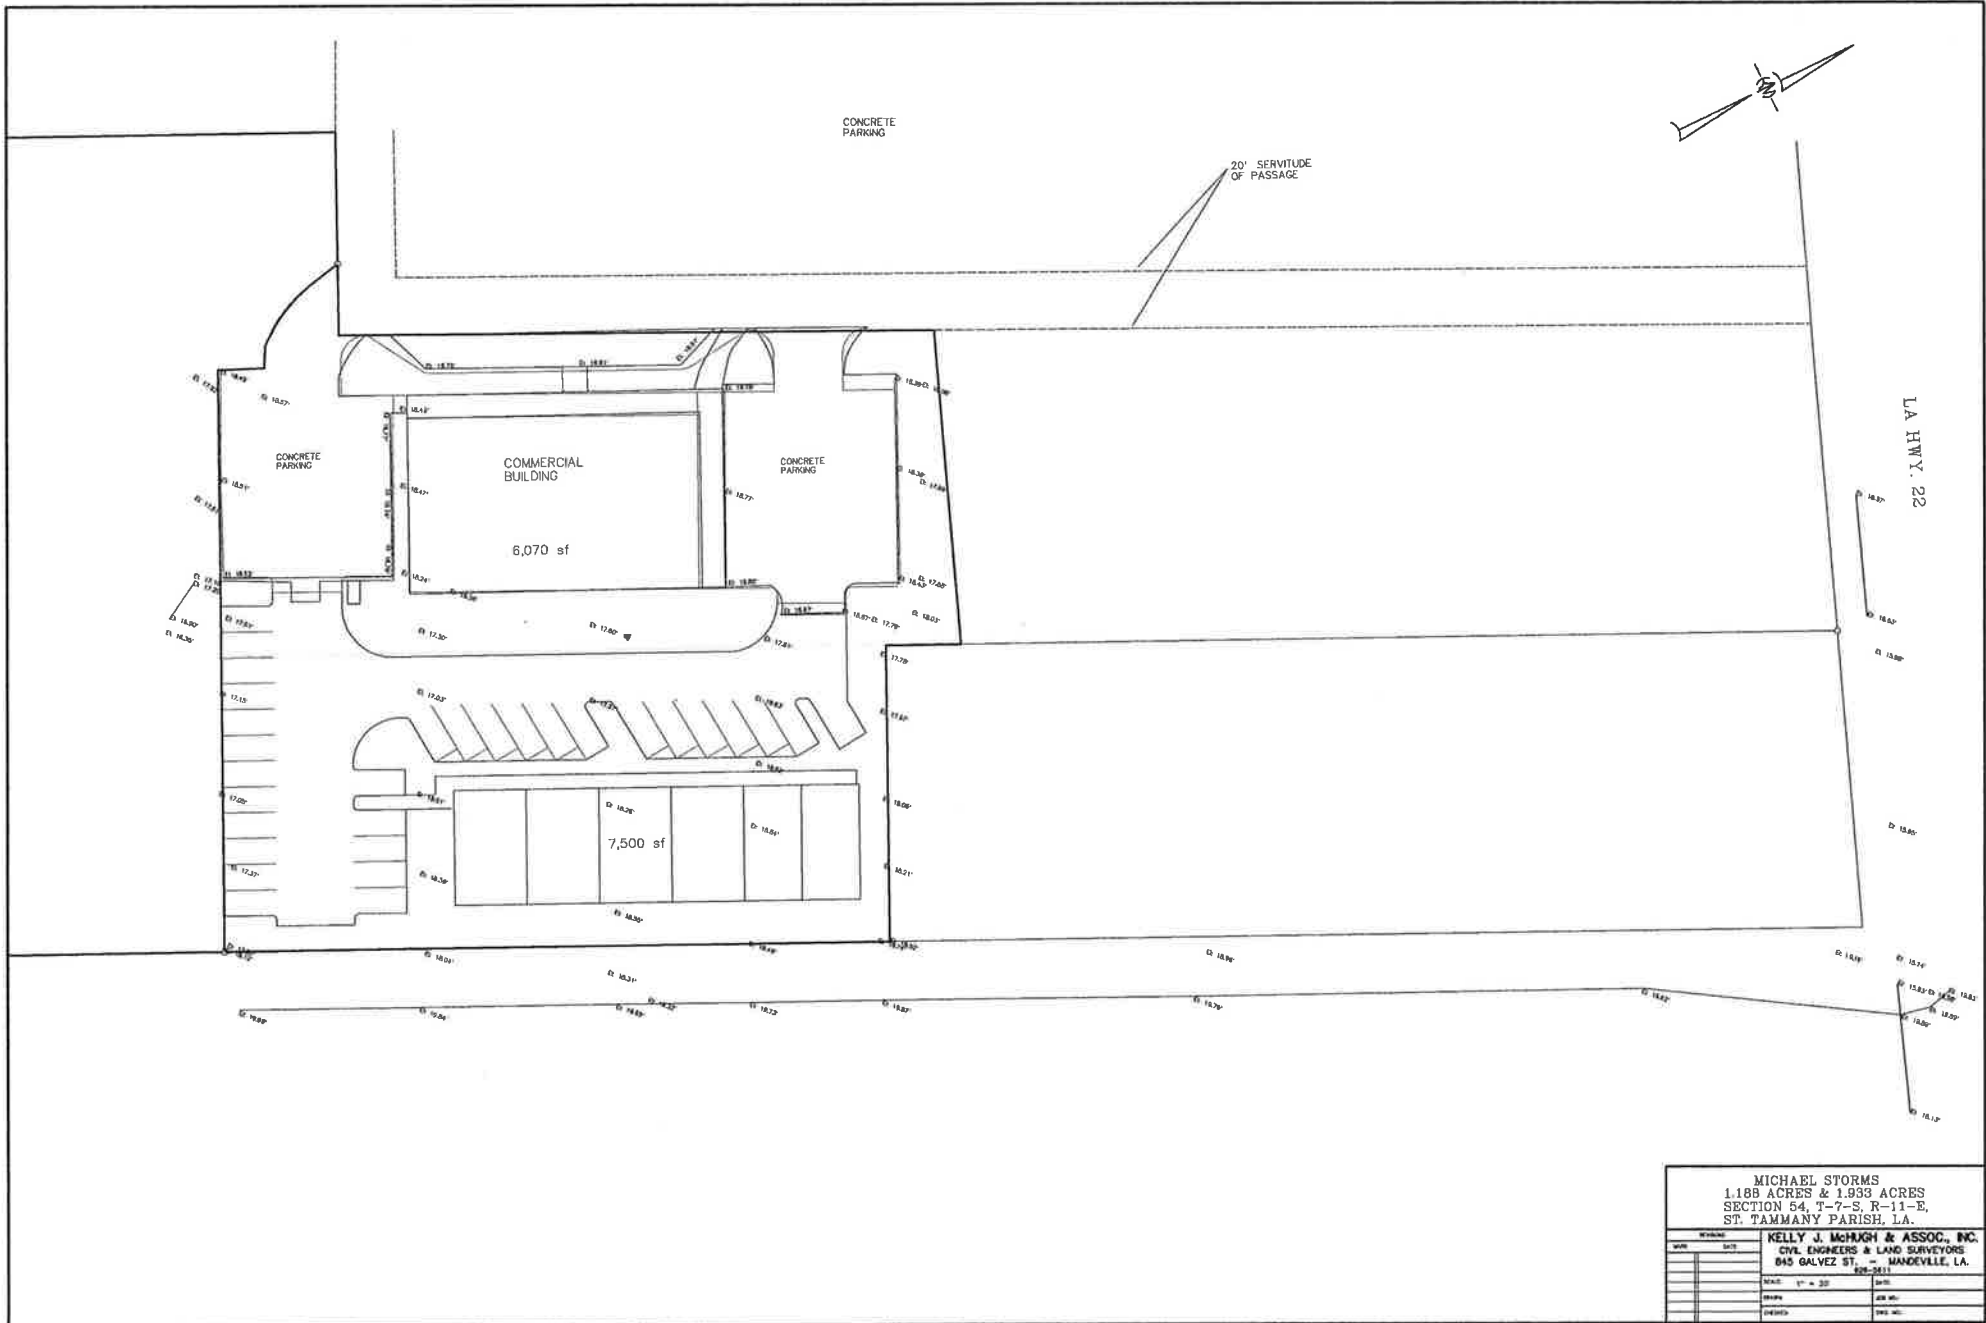


MICHAEL STORMS	
1.188 ACRES & 1.933 ACRES	
SECTION 54, T-7-S, R-11-E,	
ST. TAMMANY PARISH, LA.	
KELLY J. McHUGH & ASSOC., INC.	
CIVIL ENGINEERS & LAND SURVEYORS	
805 GALVEZ ST. - MANDEVILLE, LA.	
805-2611	
DATE	11-11-20
BY	JKH
CHECKED	JKH
DATE	11-11-20

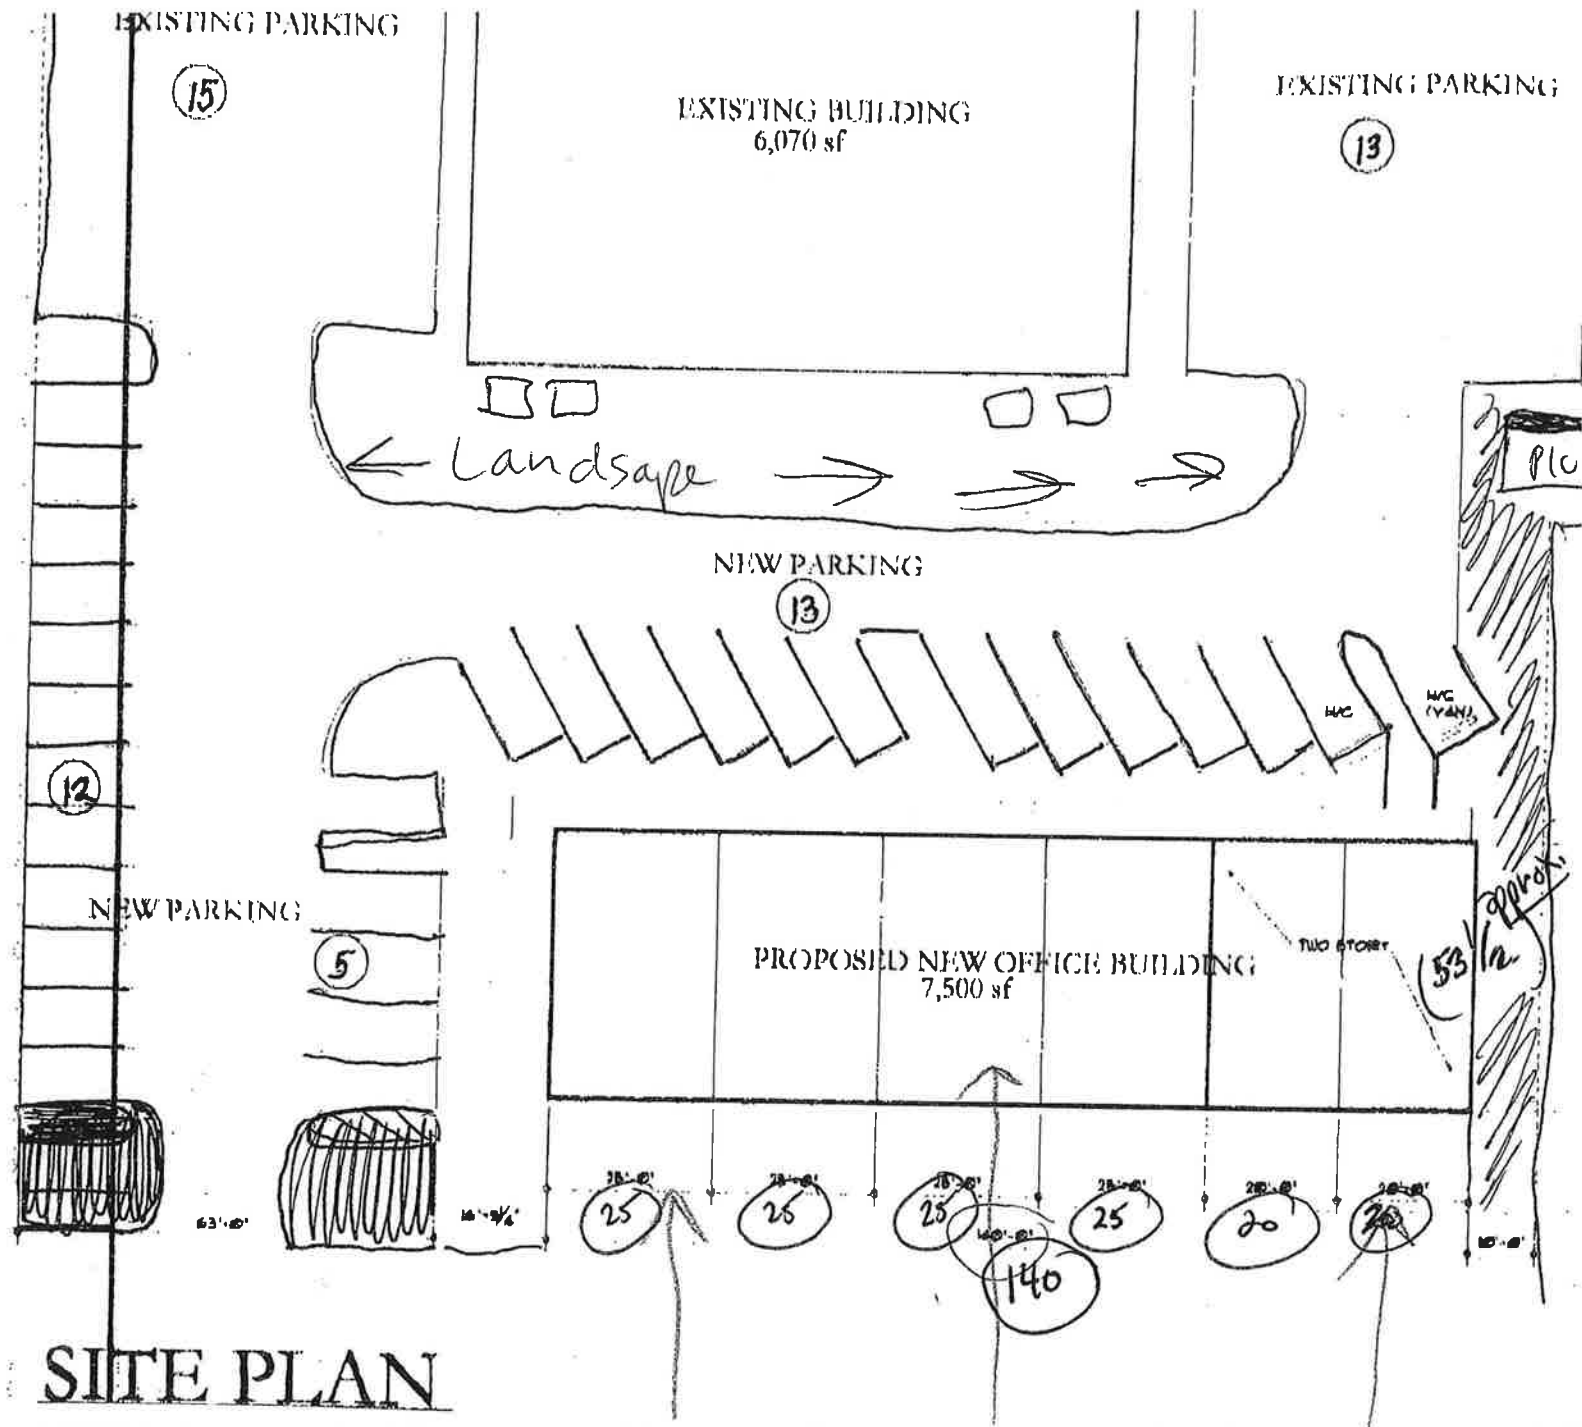

long 748-2828

very

2 story

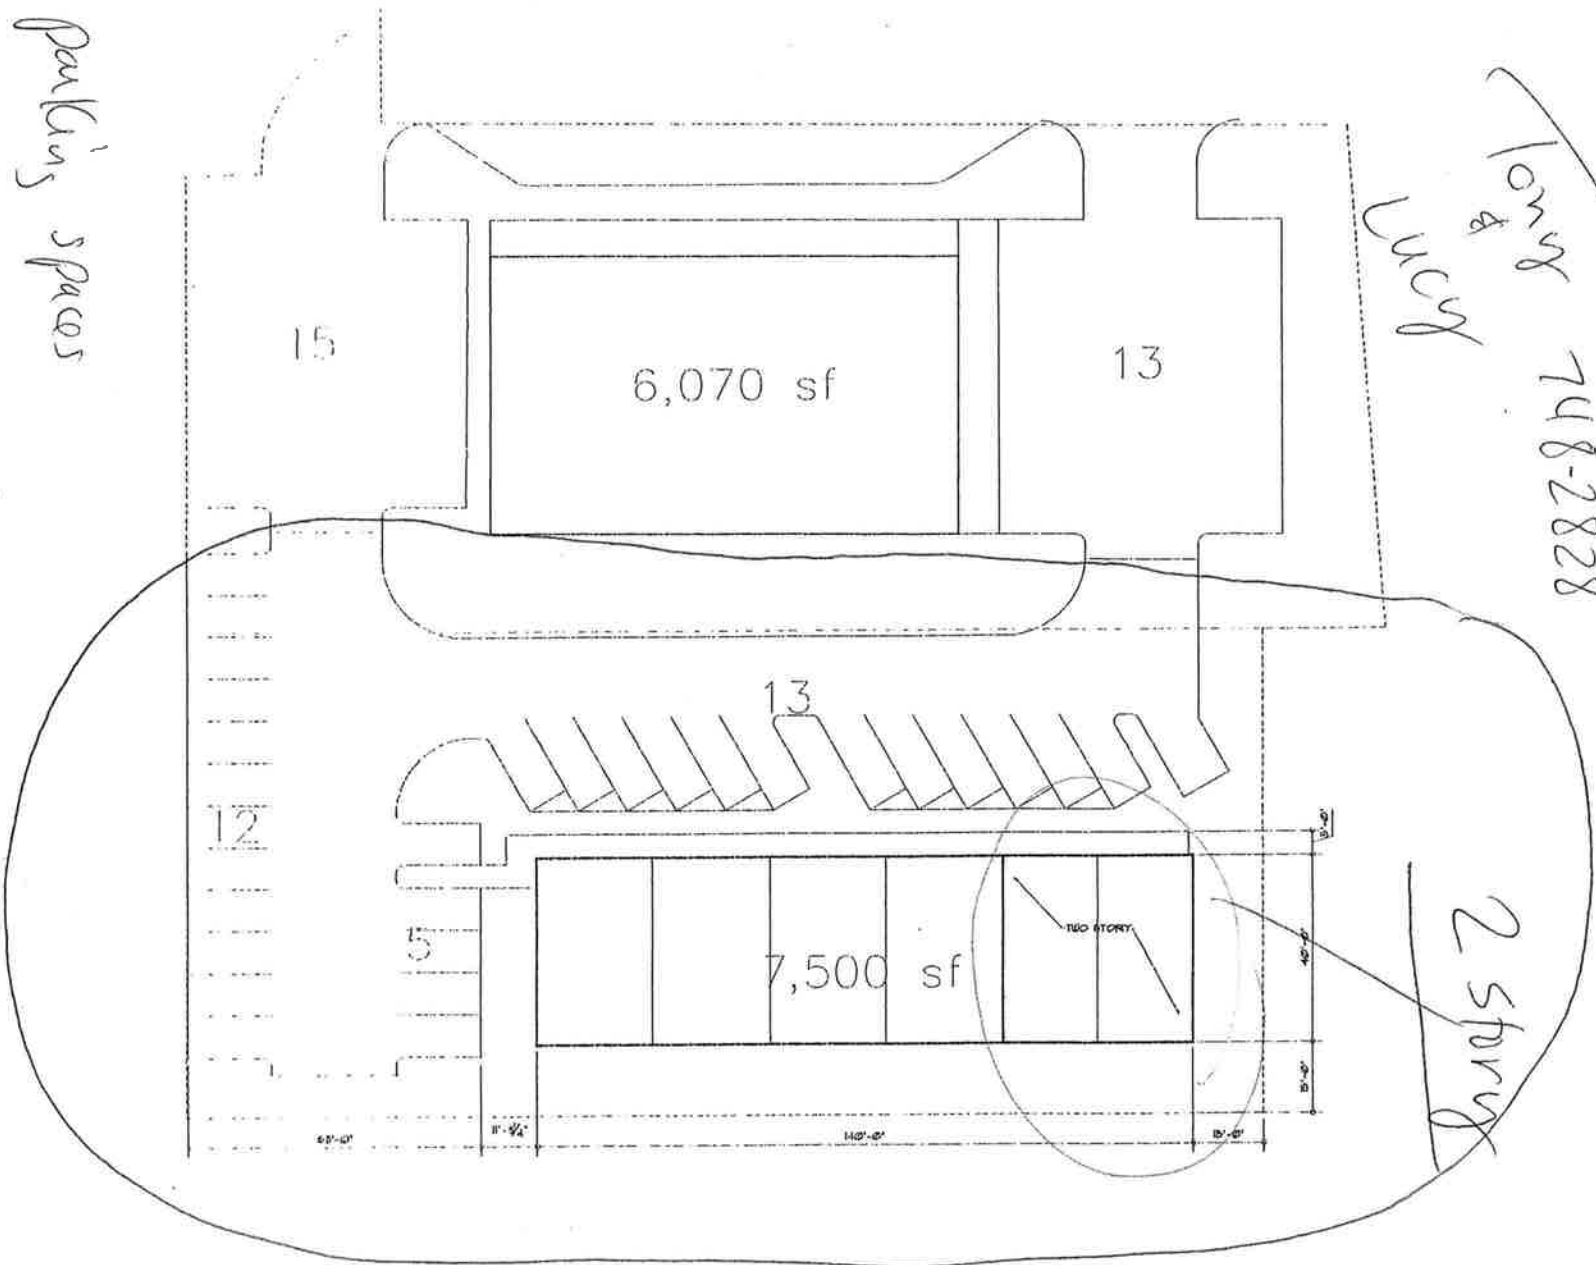

- 30 parking spaces
- 7,500 ft. (shell only - dirt floor)
- price / steel & wood
- brick / smoco (metal back)

Mike Storms