


Attached May
Aug 71
Blk 4531

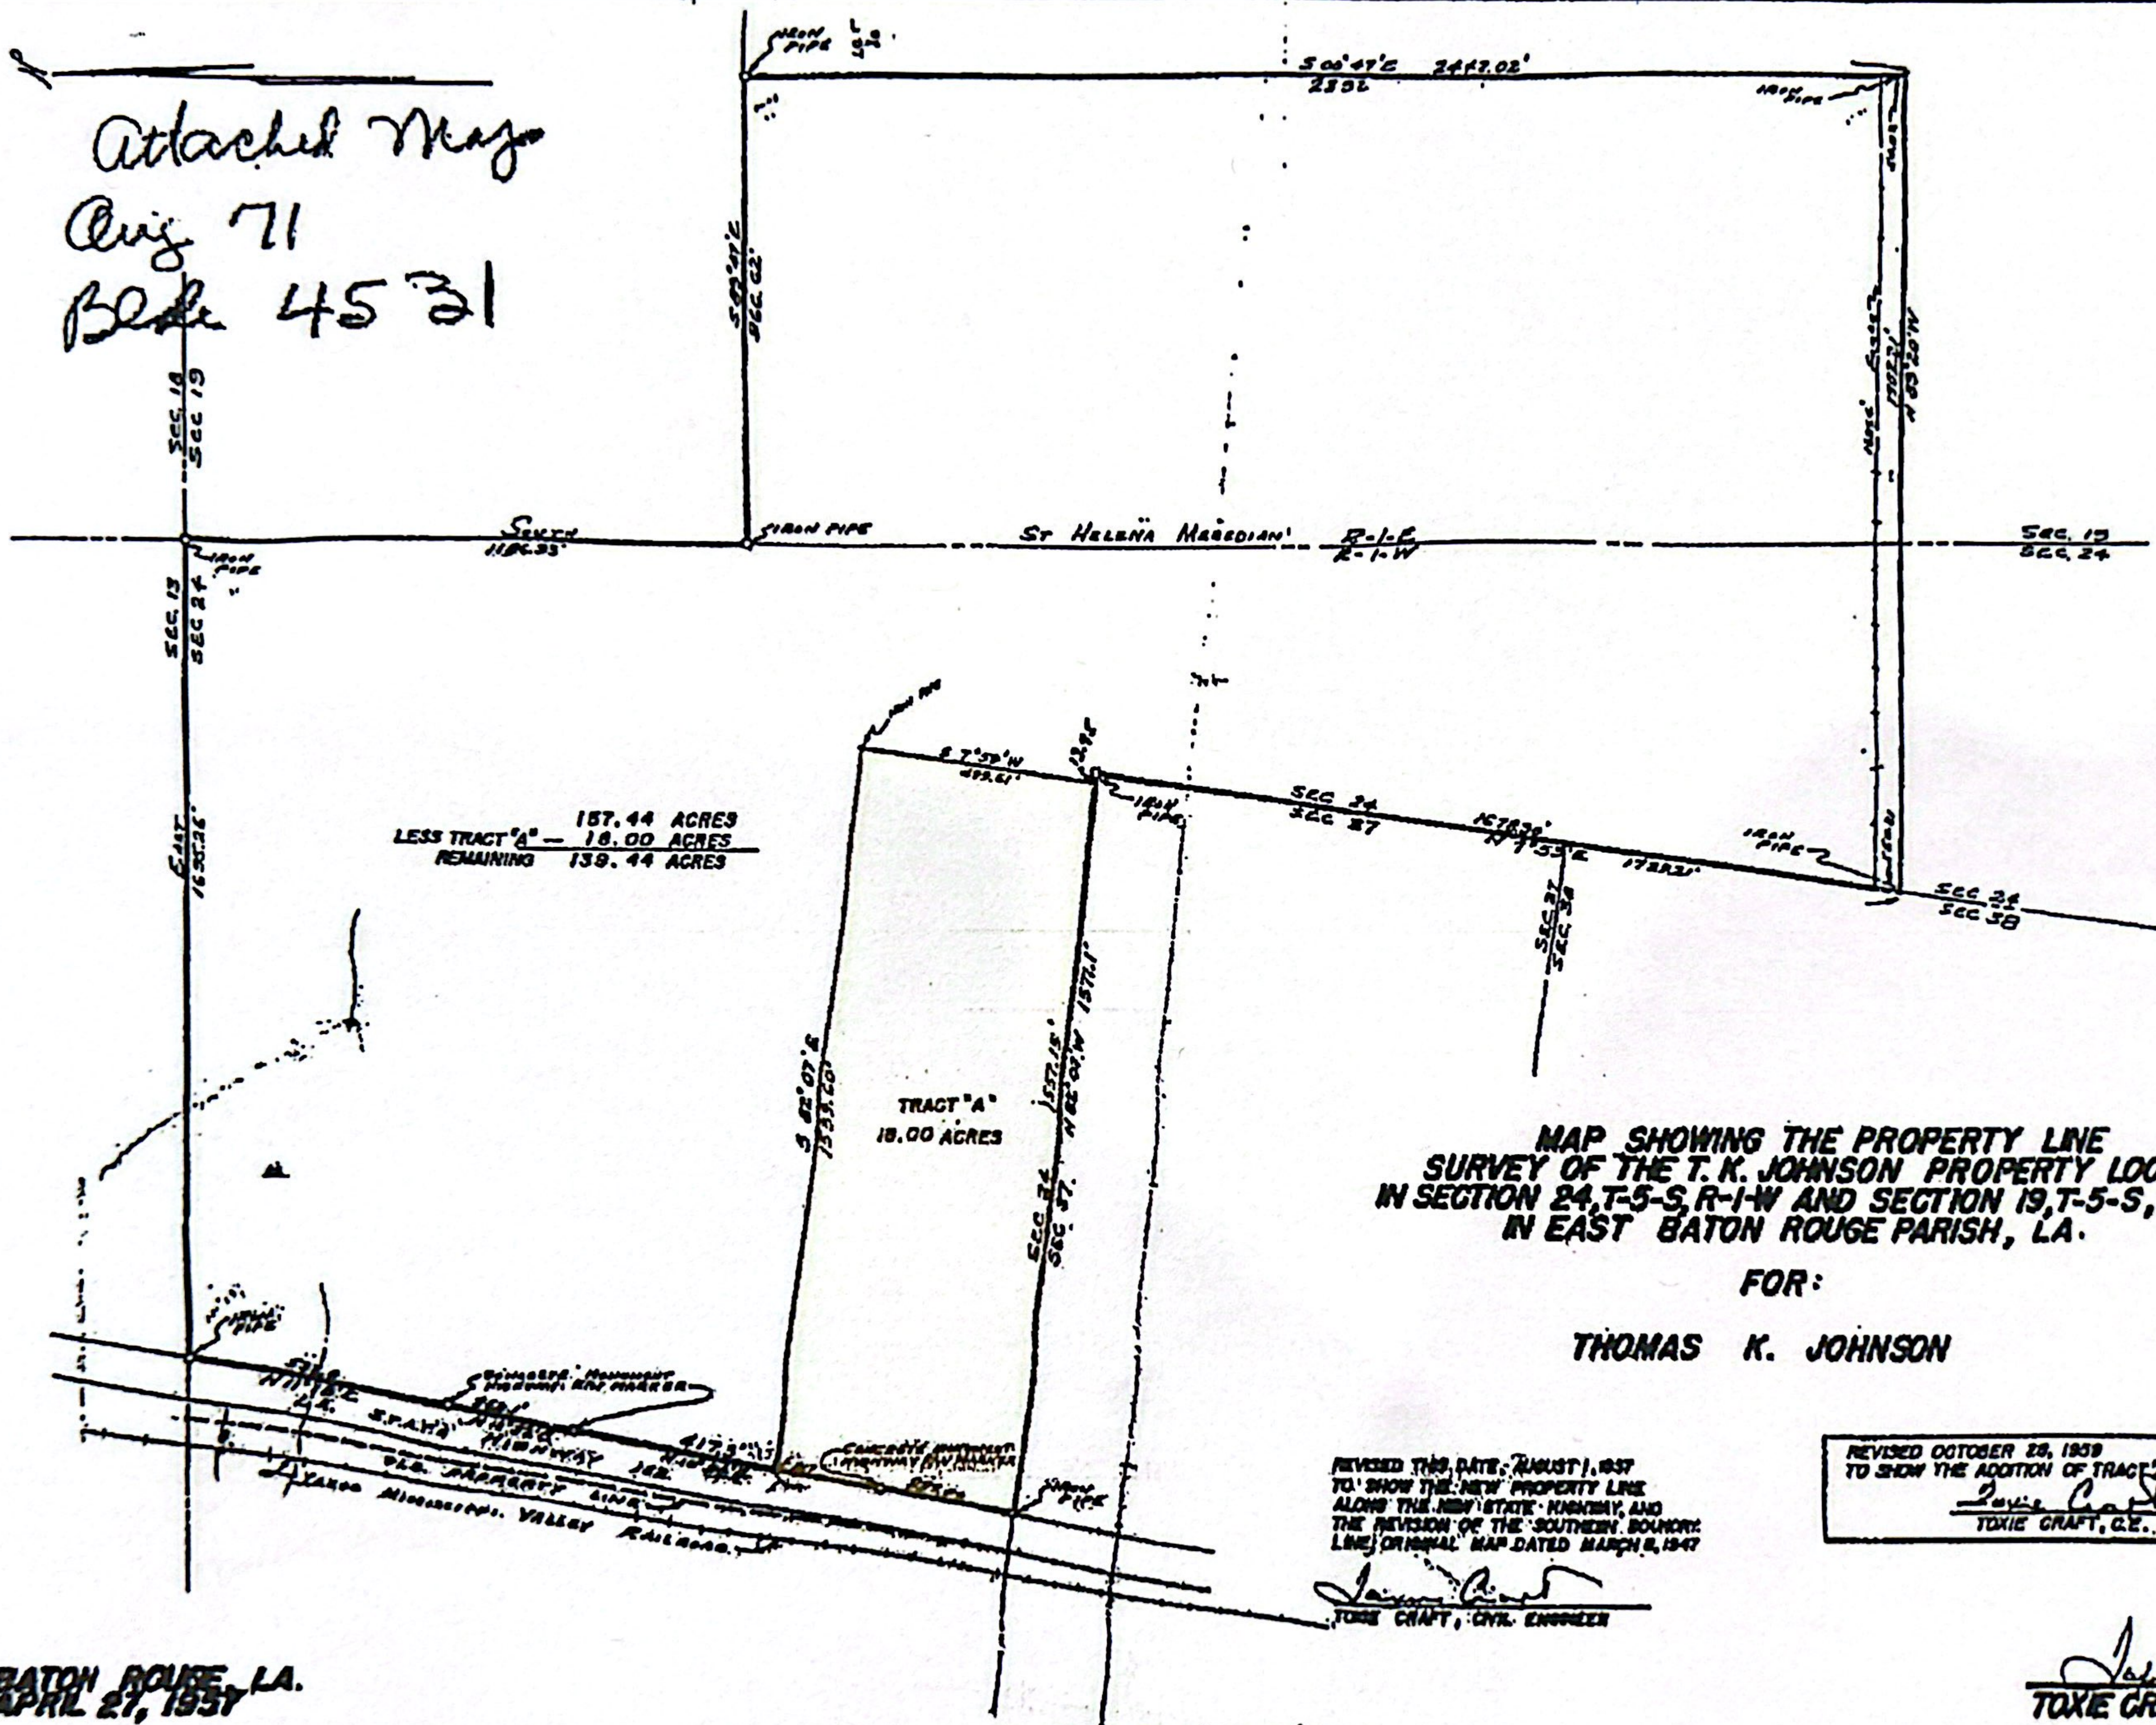

BATON ROUGE, LA.
APRIL 27, 1957

SCALE 1"=200'

REVEALED THIS DATE: AUGUST 1, 1957
TO SHOW THE NEW PROPERTY LINE
ALONG THE NEW STATE HIGHWAY, AND
THE REVISION OF THE SOUTHERN BOUNDARY
LINE; ORIGINAL MAP DATED MARCH 2, 1947

James R. Craft
JAMES CRAFT, CIVIL ENGINEER

REVISED OCTOBER 28, 1939
TO SHOW THE ADDITION OF TRACT A
Toxie Craft
TOXIE CRAFT, G.E..

TOXIN CERT

TOXIE CRAFT, CIVIL ENGINEER