


Building Sketch

Borrower/Client	N/A					
Property Address	13409 Highway 44					
City	Gonzales	County	Ascension	State	LA	Zip Code 70737
Lender	N/A					

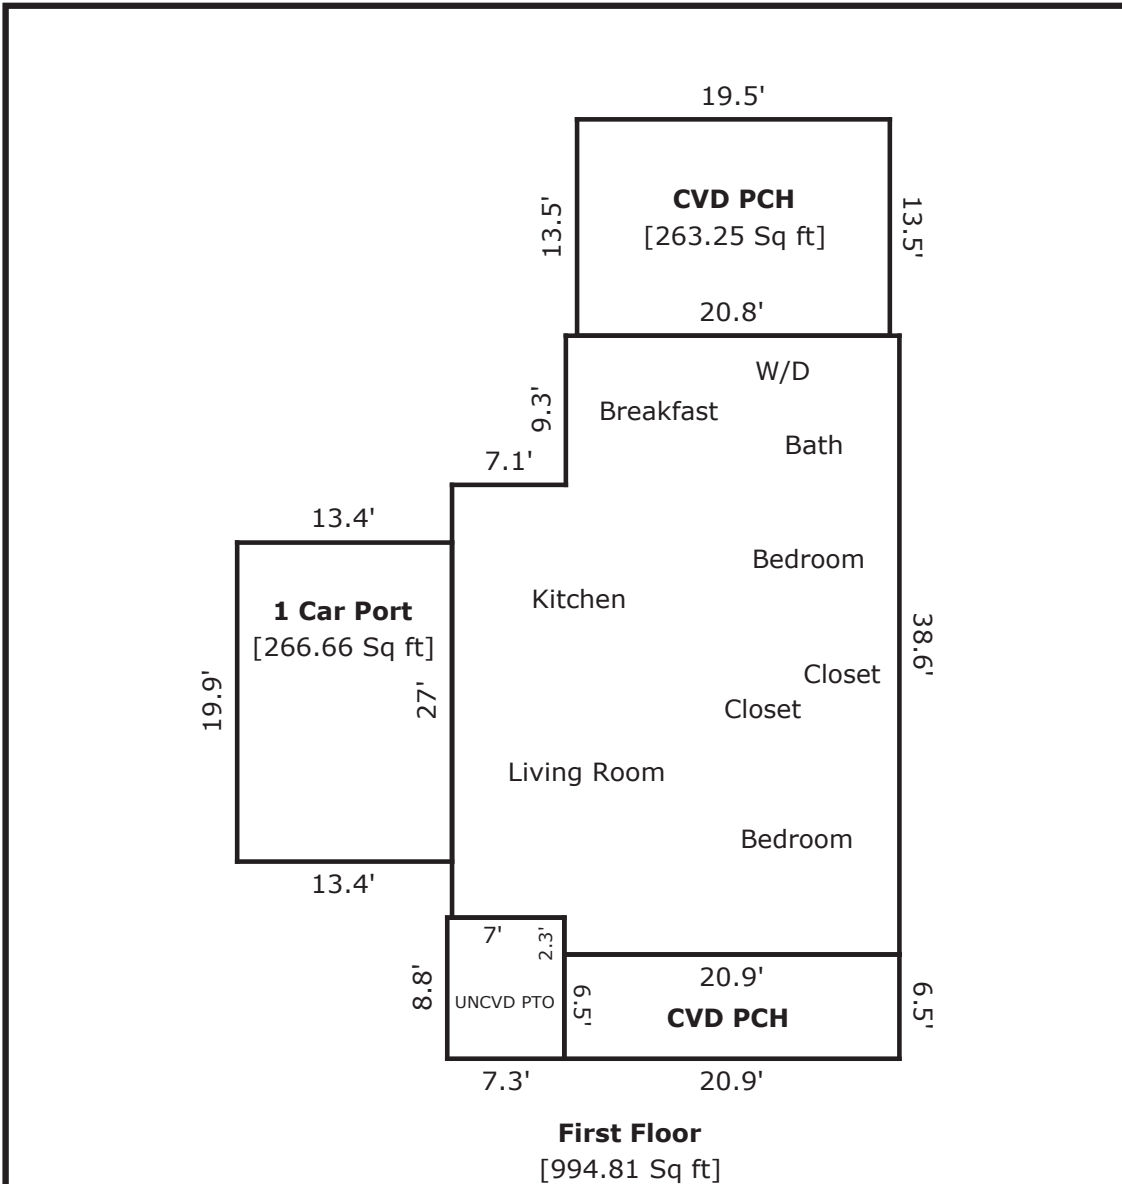

TOTAL Sketch by a la mode, inc.

Area Calculations Summary

Living Area		Calculation Details
First Floor	994.81 Sq ft	$38.6 \times 20.8 = 802.88$ $7.1 \times 27 = 191.7$ $2.3 \times 0.1 = 0.23$
Total Living Area (Rounded):		995 Sq ft
Non-living Area		
CVD PCH	135.85 Sq ft	$20.9 \times 6.5 = 135.85$
UNCVD PTO	64.24 Sq ft	$7.3 \times 8.8 = 64.24$
1 Car Port	266.66 Sq ft	$19.9 \times 13.4 = 266.66$
CVD PCH	263.25 Sq ft	$19.5 \times 13.5 = 263.25$