



# FIRST FLOOR SUITE 100

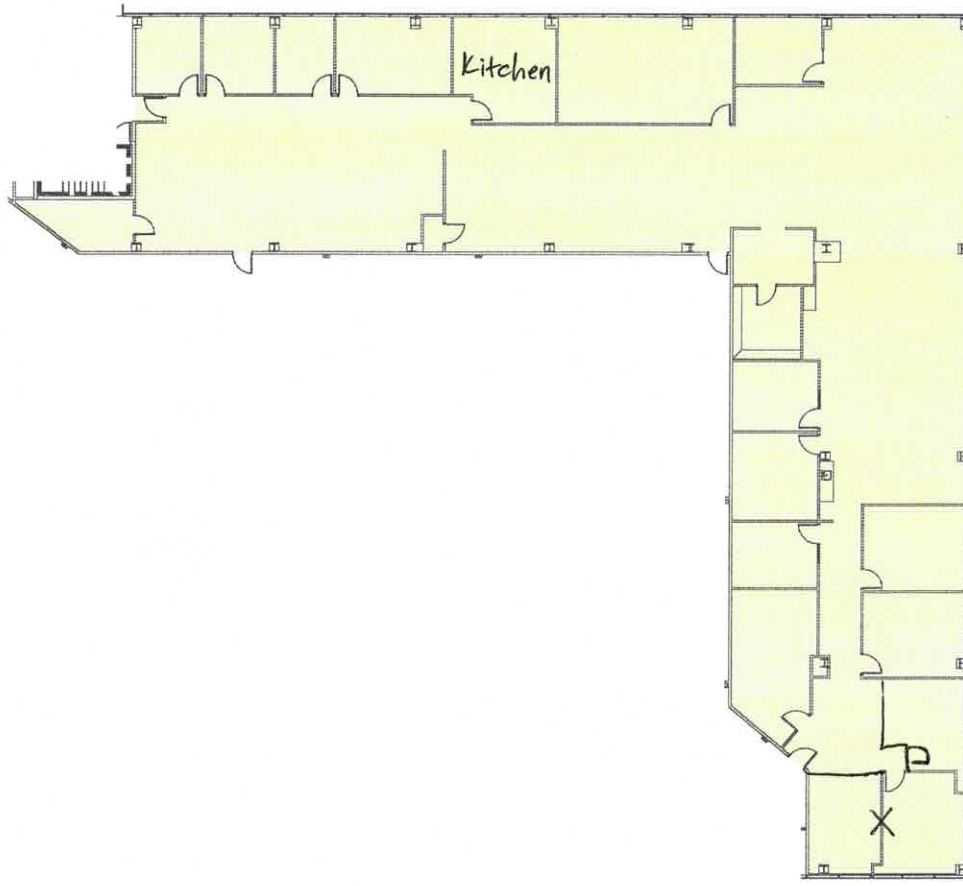

1" = 30'-0" 0 10' 20' 30' 40'

## PARKWAY PLAZA

201 ENERGY PARKWAY  
LAFAYETTE, LOUISIANA 70508

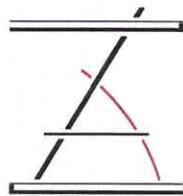


**ZILER**  
**ARCHITECTS**  
A PROFESSIONAL  
ARCHITECTURAL  
CORPORATION

JAMES O. ZILER, ARCHITECT  
SEAN R. PRIMEAUX, ARCHITECT

101 Calco Boulevard  
Lafayette, Louisiana 70503  
Ph: 337-269-6326

## 1ST FLOOR

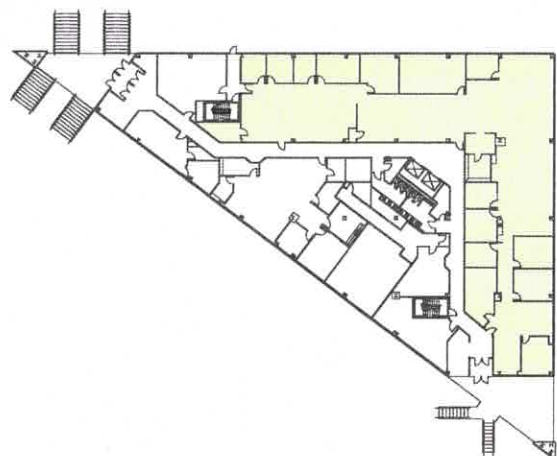

05/06/25